

Jefferson
K 2001
8-68

MISSISSIPPI
BOARD OF WATER COMMISSIONERS
416 North State Street
Jackson, Mississippi 39201

WATER WELL DRILLERS LOG

Jefferson
Jefferson

8-15-68 date well completed 168 firm name Griner Water Well Drilling county located Jefferson

LANDOWNER:
Mrs. Guy Kelly
(mailing address)

description of formations encountered	from	to
Top soil	0	3
Red clay	3	20
Blue clay	20	78
Coarse sand	78	107

WELL LOCATION:
sec. 12 T. 9 N. R. 3 E. S. 4 W.
4 miles SE of Red Hill
(distance) (direction) (nearest town)

WELL PURPOSE:
(home, irrigation, municipal, industrial)

WELL COMPLETION DATA:

(1) diameter (inches) 2"

(2) total depth (feet) 107'

(3) static water level (feet) 78' below top of ground.

(4) casing (material) (depth) 100' Galv. S.S.
2" (size) If telescope see back.


(5) screen (length) (depth to top) 5' 100'
2" (size) (material) S.S.

(6) pump (HP) (yield gpm) 1 10
electric (type power)

(7) electric log no (yes or no)

(organization running log)

(8) how well bottom plugged wood plug

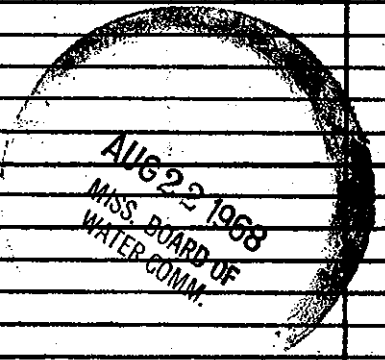

DRILLERS REMARKS: