

·····	State We	-	For Office Use Only:
County: JEFFErson	Par		
Permit #:	Office of Land and	f Environmental Quality Water Resources	Aquifer:
GRENN WATER WELL &	P.O. Box 10631		Well#:3
Driller: SUPPLY, INC.	Jackson, MS 39289-0631		L. S. Elevation:
Date drilling completed: $\frac{4-2.9-1.3}{2}$	(601)961-5210 (601)354-6938 (fax)		E-log #:
State Law requires that this report	be prepared by the d	riller in detail and filed w	vith the Department within
30 days of completion of drilling of Well Owner Information		Wel	l Location
		atitudes 310 W/ , 95	5" Longitude: <u>90 ° 47. 314</u> "
Owner Name Sam Rushing	· ·	Method of Lat/Long (circle on	1 19
Mailing Address: 1093 Block For	ster Kd.	Method of Lat/Long (circle or	ne): Conventional Survey,
			IGPS, Survey-grade GPS
Union Church, M City State	5.	NE 1/4 SE1/4 Sec 34	Twn 9 N Rng 4E
City State	Zip Code	SE Distance Direction	Nearest Town
Telephone No. ((0)) 383-2197			of Union Church
	Well Da	ita	
	-		
Purpose of Well (circle one) Home Indust	rial Public Supply	Irrigation Fish Culture	Other: <u>Foultry Far</u> wi
Date well drilling started: $4 - 29 - 13$			
If flowing, method of flow regulation: Valve	Other (dea	scribe)	
Static Water Level:feet abov	-		4-29-13
		air line other:	
Hole depth: Well depth	69	Weil grouted to a depth of _	/ O feet
	Bentonite Mix	· · ·	
		inches Type of casing:	PVC
		-	
	diameter:		
Screen slot size: $(\mathcal{O}/\mathcal{O})$ inches	Setting depth: From	49 feet to <u>6</u>	<u> </u>
Type of completion (circle all applicable):	Gravel packed Underr	eamed Telescoped Ope	n hole Natural Development
	Other (describe):		
Top of lap pipe or reduction in casing:	feet. If tel	escoped or more than one so	creen, describe on back of page
Logs run (circle all applicable) No log run	Electric Gamma Ray	Density Sonic Neutron	Other:
Name of organization running log(s): I certify that the well was drilled, construct	cted, and completed in a	ccordance with all applicab	le requirements of the Mississippi
Department of Environmental Quality and			1
GRENN WATER WELL & SUPPLY		~	
BRIAN D. McCLENDON, UNR-(0000664	Brian M-	Clendy 1
Print Name of Water Well Contractor and L	icense No.	Signature	of Water Well Contractor
L			HEGEWEL
			MAY 1 5 2013
			BY: OLWR

If well telescopes please sketch below and show depths.

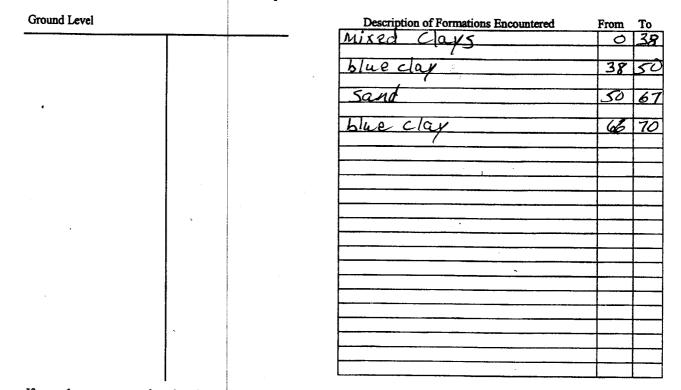

If more than one screen, show location of each on sketch

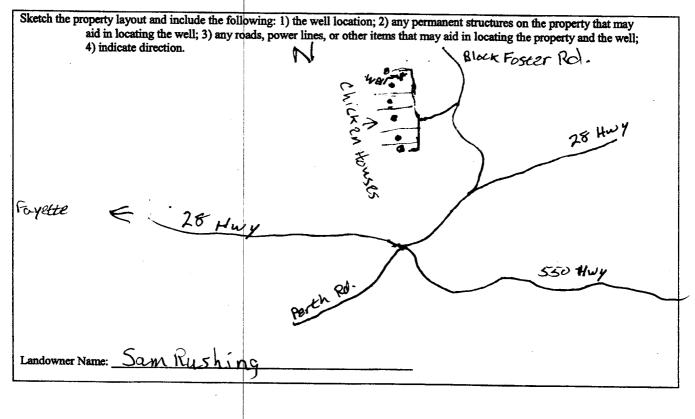

664 2 Signature of Water Well Contractor

.

County: Jeff Permit #: Driller: GRENN WA & SUPPLS Date completed: <u>S</u>	TER WELL	STATE WELL REPORT Part 2 Pump Installer's Completion Report Mississippi Department of Environmental Quality Office of Land and Water Resources P.O. Box 10631 Jackson, MS 39289-0631 (601)961-5210 (601)354-6938 (fax) the pump installer in detail and filed with the Department		For Office Use Only: Aquifer:
installation of p	ump.		_	
Well Owner Information Owner Name: <u>Sam Rushing</u> Mailing Address: <u>1093 Block Fusher Rd</u> <u>Union Church MS</u> City State Zip Code		Well Location Well Location Latitude: <u>30°41'985''</u> Longitude: <u>40°47'314</u> Method of Lat/Long (circle one): Conventional Survey, USGS quad, Hand-held GPS, Survey-grade GPS <u>NE ¼ SE ¼ Sec 34</u> Twn <u>9 N Rng 4E</u> Distance Direction		
Telephone No. (60) 383 - 2197		Miles N of Union Church		
Pump Type Circle one		Power Type Circle one		
Air Lift	Jet	Submersible	Diesel Engine Gasoli	ine Engine Natural Gas
Bucket	Piston	Turbine	Electric Motor Hand	Tractor PTO
Centrifugal Other (specify): Date Pump Installed Rated Pump Capacit	5/10/	Flowing Well		
	Pump Test D	ata		leasuring Water Level
Pumping Water Leve	A): <u>41</u> el (B): <u>56</u>	Feet Below Land Surface Feet Below Land Surface Feet Below Land Surface	Air Line Electric Me Other (specify):	Circle one sasuring Line Steel Tape shut in head:
Test Pumping Rate:	20	Gallons Per Minute	Well yielded 20	GPM with a drawdown of
WILLIAM L. H	ARDIN, V, U	tatements are true to the best NR-00000802 nse No. (if applicable)	of my knowledge.	Hard RECEN

• * *

BY: OLWP