

Jefferson  
L 2000  
10-66

MISSISSIPPI BOARD OF WATER COMMISSIONERS

WATER WELL DRILLERS LOG


Date: Oct 1, 1966, Driller: EB FORE County: Jefferson  
(Name)

(1) Owner of Land: <u>Marg M Furr</u> (Name)	Description & Color of Materials Sand, Clay, Red Clay, Shell, etc.	Thick- ness Feet	Depth Feet
<u>Union Church, Miss</u> (Address)	<u>Brown Sh. Cl. &amp; Gravel</u>	<u>15</u>	<u>18</u>
(2) Location: <u>1/4, 1/4, Sec. 1 A 44</u>	<u>White Sh. Clay</u>	<u>15</u>	<u>33</u>
<u>2</u> miles <u>E.</u> of <u>McBride</u> (distance) (direction) (Nearest Town)	<u>Blue Clay with sand streaks</u>	<u>127</u>	<u>160</u>
(3) Topography: <u>Hilly</u> (Hilly) (Flat) (Level)	<u>Sand</u>	<u>160</u>	<u>200</u>
(4) Purpose of Well: <u>Domestic</u> (Domestic Irrigation Municipal, Industrial, Other)			

Information upon completion of well:

(1) Diameter 6 1/2 inches.  
 (2) Total Depth 200' feet.  
 (3) Water Level 46' feet below top of ground.  
 (4) Cased to 190', Size 4"  
 (5) Screen: Size 2", Length 10"  
 (6) Were any formations sealed against pollution?  
 \_\_\_\_\_ yes,  no.

If YES depth of formation \_\_\_\_\_  
 Why \_\_\_\_\_  
 Drillers Remarks: H.T.H. Tablets Added

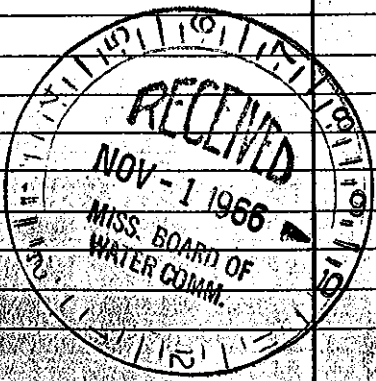

(Use Back Side)

Mail this copy to Board of Water Commissioners 429 Miss. St. Jackson, Miss.