•	State Well Report	
County: Jefferson	Part 1	Puality Aquifer: $\frac{40}{40}$
	Mississippi Department of Environmental Q Office of Land and Water Resources	
Permit #: Driller: <u>Ganz Rayborn</u>	P.O. Box 10631	
J J J G L I	Jackson, MS 39289-0631 (601)961-5210	L. S. Elevation:
Date drilling completed:	(601)354-6938 (fax)	E-log #:
State Law requires that this repo 30 days of completion of drilling	ort be prepared by the driller in detail and of the well.	
Well Owner Informa	tion	Well Location
wher Name_ Honewood		<u>8.24</u> " Longitude: <u>91.1.1.</u> "
Mailing Address: <u>C/O Sam M</u>	iddleton Method of Lat/Long	(circle one): Conventional Survey,
1709 Robi		land-held GPS, Survey-grade GPS
		Sec. 35 Twn SN_{Rng} IW
City Sta	Distance D	irection Nearest Town of <u>Canoonsburg</u>
	Well Data	
Purpose of Well (circle one Home) / Ind	lustrial Public Supply Irrigation Fish (Culture Other:
Date well drilling started:	Date well drilling complete	d: 1/18/2011
If flowing, method of flow regulation: Va	lve Other (describe)	
Static Water Level: <u>65</u> feet al	bove or below circle one) land surface Date 1	neasured: 118/2011
	literi tape	her:
Hole depth: <u>120'</u> Well de	epth: <u>120'</u> Well grouted to a	depth of 50 feet
Type of grout (circle one): Cement	Bentonite Mix	0.10
Casing length: 100 feet Cas	ing diameter: <u>4</u> inches Type o	f casing:PVC
Screen length: <u>20</u> feet Scr	een diameter: <u> </u>	f screen: <u>PVC</u>
Screen slot size: <u>010</u> inches		t to <u>120</u> feet
Type of completion (circle all applicable)	Gravel packed Underreamed Telescope	ed Open hole Natural Development
н. 	Other (describe):	
Top of lap pipe or reduction in casing:	feet. If telescoped or more th	an one screen, describe on back of page
Logs run (circle all applicable): No log r	un Electric Gamma Ray Density Sonic	Neutron Other:
Name of organization running log(s):		amiliantly requirements of the Micciscinni
I certify that the well was drilled, const	tructed, and completed in accordance with all	regulations and state laws.
	and/or the Mississippi Department of Health	
RAYBORN DRILLING, IN	0-60	<u> </u>
Print Name of Water Well Contractor an	d License No.	Signature of Water Well Contractor
•		FEB 1 7
,		

.


· ·

If well telescopes please sketch below and show depths.



Description of Formations Encountered	From	
CHALK	0	65
Fine Sand	65	75
Coarse Sand	15	100
Fine Sand Coarse Sand Pea Gravel	100	120
· · · · · · · · · · · · · · · · · · ·	+	<u> </u>
		\vdash
•		
		+
		<u>+</u>
		<u> </u>

If more than one screen, show location of each on sketch

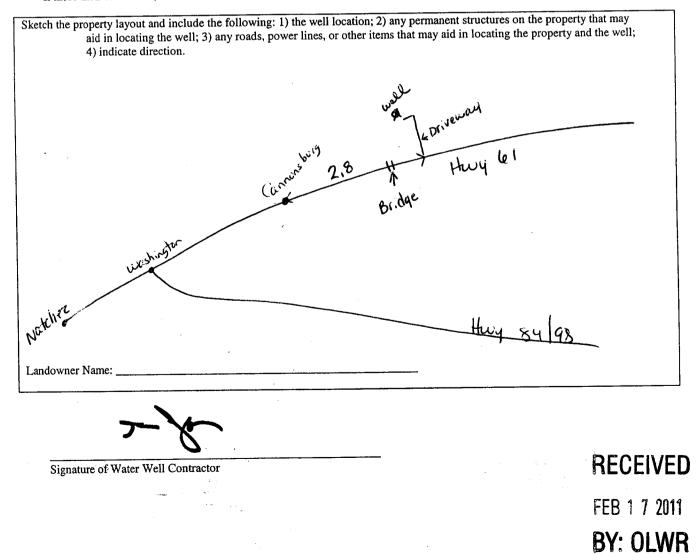

		LL REPORT			
County:	Part 2 Pump Installer's Completion Report Mississippi Department of Environmental Quality Office of Land and Water Resources		For Office Use Only: Aquifer:		
County: <u>Jetterson</u> , Permit #: Driller: <u>Gary Rayborn</u> Data completed: 1-18-2011	Jackson, M	ox 10631 S 39289-0631 961-5210	Well #:		
	(601)354	Elevation:			
This report should be prepared by t installation of pump. Well Owner Informa			Location		
Owner Name: Homewood C		Latitude:	_ Longitude:		
Mailing Address: <u>Clo Sam Middleton</u>		Method of Lat/Long (circle one): Conventional Survey,			
1709 Rubinson St.		USGS quad, Hand-held GPS, Survey-grade GPS			
Natcher MS 39120		<u>14 Sec 35 Twn 8N Rng 1W</u>			
City State	City State Zip Code		Distance Direction Nearest Town		
Telephone No. ()		2.8 Miles <u>E</u>	of <u>Cannonsburg</u>		
Pump Type Circle one			ower Type Circle one		
Air Lift Jet	Submersible .	Diesel Engine Gasol	ine Engine Natural Gas		
Bucket Piston	Turbine (Electric Motor Hand	Tractor PTO		
Centrifugal Rotary	Flowing Well	1	r (specify):		
Other (specify):		Horse Power Rating of Moto			
Date Pump Installed:		Setting Depth: <u>1</u> C	/ /feet		
Rated Pump Capacity:	Gallons Per Minute	Number of Stages:	<u> </u>		
Pump Test Da			Ieasuring Water Level Circle one		
Date Well Tested:	_011	Air Line Electric M	easuring Line) Steel Tape		
Static Water Level (A): 65 F	eet Below Land Surface				
Pumping Water Level (B):Fe	et Below Land Surface				
Drawdown [(B) – (A)]:F	eet Below Land Surface		shut in head:feet		
Test Pumping Rate:	Gallons Per Minute		GPM with a drawdown of		
Duration of Pump Test (minimum 4 hou	rs):hours	feet after	hours of pumping		
I HEREBY CERTIFY that the above sta	tements are true to the best $\int dx dx = \int dx$	of my knowledge.	- 7		
Print Name of Pump Installer and Licen	$\underline{\bigcup - \mathcal{Q} \mathcal{Q}}$ se No. (if applicable)	Signature of Pump	RECEIVE		
9			FEB 1 7 201		
			BY: OLW		