

Jefferson
 M 2013
 3-12-81

MISSISSIPPI DEPARTMENT OF NATURAL RESOURCES
 Bureau of Land and Water Resources
 Southport Mall
 P.O. Box 10631
 Jackson, Mississippi 39209
 WATER WELL DRILLERS LOG

March 12 1981 Rever Miller Jefferson
 date well completed firm name county well located

LANDOWNER:
Allen Jones
Church Hill
 (mailing address)


WELL LOCATION:
 sec. 11 T. 8 N R. 1 W
3 miles South of Church Hill
 (distance) (direction) (nearest town)

WELL PURPOSE: Local
 (home, irrigation, municipal, industrial)

WELL COMPLETION DATA:
 (1) diameter (inches) 4"
 (2) total depth (feet) 193
 (3) static water level (feet) 130 below top of ground.
 (4) casing plastic bottom
 (material) (depth)
 _____ if telescope see back.
 (size)
 (5) screen 5' 188'
 (length) (depth to top)
4" plastic
 (size) (material)
 (6) pump 1/2 15
 (HP) (yield gpm)
slit
 (type power)
 (7) electric log no
 (yes or no)

 (organization running log)
 (8) how well bottom plugged
Backwash

description of formations encountered	from	to
Clay	0	22
Orange sand	22	46
White Chalk	46	110
Dark brown sand	110	140
Coarse sand & pebbles	140	193

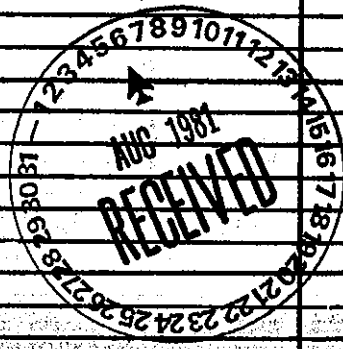

DRILLERS REMARKS:
