

MISSISSIPPI DEPARTMENT OF NATURAL RESOURCES

Bureau of Land and Water Resources

Southport Mall

P.O. Box 10631

Jackson, Mississippi 39209

CODED

WATER WELL DRILLERS LOG

Jefferson
M
6-25-81
2025

6-18 1981 Rayborn Drill & Const. Co. Jefferson
date well completed firm name county well located


| LANDOWNER: | description of formations encountered | from | to |
|--|---------------------------------------|-----------|------------|
| <u>Gandy Griffin</u> <u>Jayette, Ms.</u> (mailing address) | | | |
| | <u>Clay</u> | <u>2</u> | <u>70</u> |
| | <u>Sand</u> | <u>70</u> | <u>134</u> |

WELL LOCATION:
sec. 50 T. 8 N. R. 1 E.
3/4 miles East of Carmichael
(distance) (direction) (nearest town)

WELL PURPOSE: Home
(home, irrigation, municipal, industrial)

- WELL COMPLETION DATA:
- (1) diameter (inches) 2"
 - (2) total depth (feet) 154'
 - (3) static water level (feet) 80' below top of ground
 - (4) casing galv. 147'
(material) (depth)
2" If telescope see back.
(size)
 - (5) screen 5' 147'
(length) (depth to top)
2" SS
(size) (material)
 - (6) pump 1 660
(HP) (yield gpm)
elec.
(type power)
 - (7) electric log no.
(yes or no)
(organization running log)
 - (8) how well bottom plugged wood plug

CODED

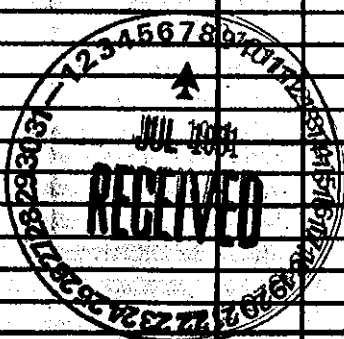

DRILLERS REMARKS: