

JEFF  
N

MISSISSIPPI

WATER WELL DRILLERS LOG

N (or) 0

1-14-61

Date: 1/14, 1961, Driller: GRUBER WATER WELL SERVICE, County: JEFFERSON

(Name)

(1) Owner of Land: Mrs. Dee Fairley  
(Name)  
Fayette, Miss.  
(Address)

(2) Location: 1/4, 1/4, Sec. T 8 R 1 E  
2 miles south, of Fayette  
(distance) (direction) (Nearest Town)

(3) Topography: Hilly  
(Hilly) (Flat) (Level)

(4) Purpose of Well: Home  
(Domestic Irrigation, Municipal, Industrial, Other)

Description & Color of Materials Sand, Clay, Red Clay, Shell, etc.	Thick- ness Feet	Depth Feet
TOP SOIL	0-3	
BROWN CLAY	3-14	
GRAVEL	14-45	
GRAY CLAY	45-60	
FINE SAND	60-72	
GRAY CLAY	72-130	
Blue CLAY	130-225	
SAND	225-260	

Information upon completion of well:

(1) Diameter: 2 inches.

(2) Total Depth: 260 feet.

(3) Water Level: 150 feet below top of ground.

(4) Cased to: 25.5, Size: 2"


(5) Screen: Size: 8', Length: 5'

(6) Were any formations sealed against pollution?  
yes,  no.

If YES depth of formation \_\_\_\_\_

Why \_\_\_\_\_

Drillers Remarks: \_\_\_\_\_

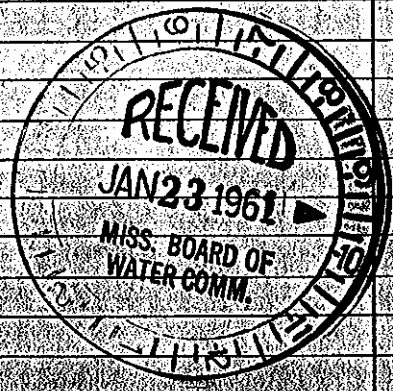

(Use Back Side)

Well No.