	- State Well	Report		
County: Jefferson	Part	_	For Office Use Only:	
	Mississippi Department of Environmental Quality		Aquifer: 0/7	
Permit #:	Office of Land and Water Resources		Well #:	
Driller: Gary Kayborn	P.O. Box 10631		well #:	
	Jackson, MS 3		L. S. Elevation:	
Date drilling completed: 42111	(601)961 (601)354-69		E-log #:	
		So (tury)		
State Law requires that this re 30 days of completion of drillin		ler in detail and filed w	ith the Department within	
Well Owner Inform		Well	Location	
wner Name_Jeff Bair		titude: <u>31 • 37 • 41</u>	" Longitude: <u>91.02.21</u> "	
lailing Address: <u>Red Tiffe</u>		ethod of Lat/Long (circle on	e): Conventional Survey,	
	<u>y 129</u>		GPS, Survey-grade GPS	
Monterey La 71354 IP 1/4 IP		14 14 Sec_ 32	<u>Twn 8N Rng 2E</u>	
Celephone No. (<u>318)</u> 386 - 2		stance Direction	Nearest Town of <u>MC NG r</u>	
Well Data				
	udustrial Public Supply In	rigation Fish Culture	Other:	
		5		
Pate well drilling started:2	2111 Date well	drilling completed: 2	- 21111	
f flowing, method of flow regulation: V	alve Other (descr	ibe)		
1	above or below (gircle one) land		2 21 11	
Method of Measurement (circle one)	steel tape electric tape	air line other:	······································	
Hole depth: 95^{1} Well of	depth:		feet	
Type of grout (circle one): Cement			- 10	
Casing length: 15 feet Casing diameter: 4 inches Type of casing: 4				
Screen length: <u>20</u> feet Screen diameter: <u>4</u> inches Type of screen: <u>PVC</u>				
Screen slot size: <u>1010</u> inches Setting depth: From <u>75</u> feet to <u>95</u> feet				
Type of completion (circle all applicable	e): Gravel packed Underread Other (describe):	med Telescoped Open	hole Natural Development	
Type of completion (circle all applicable Fop of lap pipe or reduction in casing:	e): Gravel packed Underread Other (describe):feet. If teles	med Telescoped Open	n hole Natural Development	
Fype of completion (circle all applicable Top of lap pipe or reduction in casing:	e): Gravel packed Underread Other (describe):feet. If teles	med Telescoped Open	n hole Natural Development	
Type of completion (circle all applicable Top of lap pipe or reduction in casing: _ Logs run (circle all applicable): No log Name of organization running log(s):	e): Gravel packed Underread Other (describe): feet. If teles run Electric Gamma Ray I	med Telescoped Oper coped or more than one sc Density Sonic Neutron ordance with all applicable	h hole Natural Development reen, describe on back of page Other: e requirements of the Mississipp	
Type of completion (circle all applicable Top of lap pipe or reduction in casing: _ Logs run (circle all applicable): No log Name of organization running log(s):	e): Gravel packed Underread Other (describe): feet. If teles run Electric Gamma Ray I	med Telescoped Oper coped or more than one sc Density Sonic Neutron ordance with all applicable	h hole Natural Development reen, describe on back of page Other: e requirements of the Mississipp	
Type of completion (circle all applicable Top of lap pipe or reduction in casing: Logs run (circle all applicable): No log <u>Name of organization running log(s):</u> I certify that the well was drilled, com Department of Environmental Qualit	e): Gravel packed Underread Other (describe): feet. If teles run Electric Gamma Ray I istructed, and completed in acc y and/or the Mississippi Depar	med Telescoped Open coped or more than one sc Density Sonic Neutron ordance with all applicable tment of Health regulation	h hole Natural Development reen, describe on back of page Other: e requirements of the Mississippi	
Type of completion (circle all applicable Top of lap pipe or reduction in casing: Logs run (circle all applicable): No log <u>Name of organization running log(s):</u> I certify that the well was drilled, com Department of Environmental Qualit	e): Gravel packed Underread Other (describe): feet. If teles run Electric Gamma Ray I structed, and completed in accord y and/or the Mississippi Depar	med Telescoped Open coped or more than one sc Density Sonic Neutron ordance with all applicable tment of Health regulation	h hole Natural Development reen, describe on back of page Other: e requirements of the Mississippi	


BY: OLWR

If well telescopes please sketch below and show depths.

Ground Level

Level	Description of Formations Encountered	From	
	- Chalk Fine Sad	0 45	75 55
	Coarse Sand and Pea Gravel	55	95

If more than one screen, show location of each on sketch

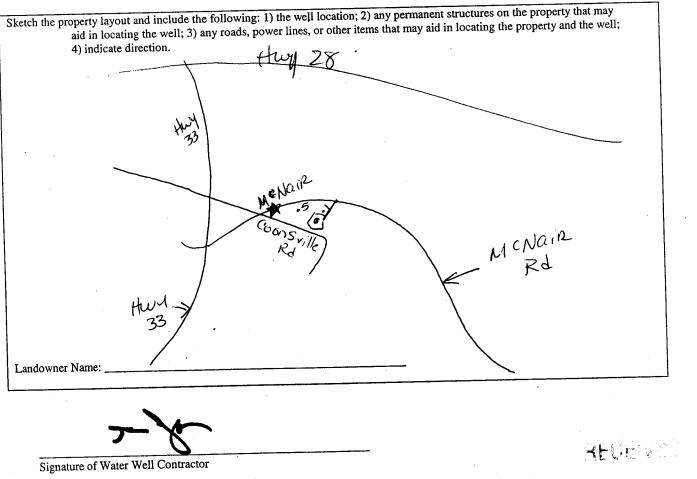

MAR 1 5 2011 BY: OLWR

· · ·				
STATE WELL REPORT				
ToPacas	Part 2 Installer's Completion Report For Office Use Only:			
Mississippi I	Department of Environmental Quality Aquifer:			
	P.O. Box 10631			
Driller: Gary Rayborn	Jackson, MS 39289-0631 Well #:			
Date completed: _2 21 11	(601)961-5210 (601)354-6938 (fax) Elevation:			
installation of nump.	er in detail and filed with the Department within 30 days of the			
Well Owner Information	Well Location			
Owner Name: Red Tiffee	Latitude:Longitude:			
Mailing Address: 7281 Hwy 129	Method of Lat/Long (circle one): Conventional Survey,			
	USGS quad, Hand-held GPS, Survey-grade GPS			
Monterey La 7135 City State Zip Co	<u>4</u> <u>14</u> <u>14 Sec 32 Twn 8N Rng 2E</u>			
City State Zip Co	de Distance Direction Nearest Town			
Telephone No. (318) 386-2802	∞5 Miles E of MCNair			
Telephone No. (<u>5.5)</u>				
Pump Type	Power Type			
Circle one	· Circle one			
Air Lift Jet Submersible	Diesel Engine Gasoline Engine Natural Gas			
Bucket Piston Turbine	Electric Motor Hand Tractor PTO			
Centrifugal Rotary Flowing We				
Other (specify):	Horse Power Rating of Motor:			
2/22/11	Setting Depth:75feet			
	12			
Rated Pump Capacity: Gallons Per M	Minute Number of Stages:			
	Method of Measuring Water Level			
Pump Test Data	Circle one			
Date Well Tested: 22211	Air Line Electric Measuring Line Steel Tape			
Static Water Level (A):Feet Below Land	Surface			
Pumping Water Level (B):Feet Below Land S	Surface Other (specify):			
Drawdown [(B) – (A)]:Feet Below Land	Surface For flowing well, measured shut in head:feet			
Test Pumping Rate:				
Duration of Pump Test (minimum 4 hours):	hoursfeet afterhours of pumping			
I HEREBY CERTIFY that the above statements are true	to the best of my knowledge.			
Coc Rather O-100				
Print Name of Pump Installer and License No. (if applicable) Signature of Pump Installer				
Time stand of Fully industed and Scotter 2.3. (a spin				

MAR 1 5 2011 BY: OLWR