

JEFF. MISSISSIPPI

ER COMMISSIONERS

2000 WATER WELL DRILLERS LOG

8-2-60

Date: 8/2/1960, Driller: GRIND WATER WELL County: FAVETTE
(Name)

(1) Owner of Land: Mrs. Denise Allred
(Name)
FAYETTE, MISS.
(Address)

(2) Location: 1/4, 1/4, Sec. T 8 R 2 E
8 miles SOUTH EAST, of FAYETTE
(distance) (direction) (Nearest Town)

(3) Topography: HILLY
(Hilly) (Flat) (Level)

(4) Purpose of Well: Home
(Domestic Irrigation
Municipal, Industrial, Other)

Description & Color of Materials Sand, Clay, Red Clay, Shell, etc.	Thick- ness Feet	Depth Feet
To soil	0	4
Red Clay	4	15
SAND & GRAVEL	15	120
GRAY CLAY	120	240
COARSE SAND	240	288


Information upon completion of well:

- (1) Diameter 2 inches.
- (2) Total Depth 288 feet.
- (3) Water Level 154 feet below top of ground.
- (4) Cased to 280, Size 2"
- (5) Screen: Size 2", Length 6'
- (6) Were any formations sealed against pollution?
_____ yes, X no.

If YES depth of formation _____

Why _____

Drillers Remarks: _____

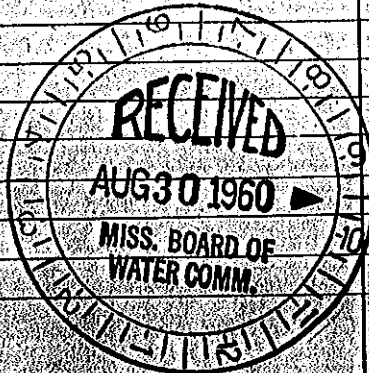

(Use Back Side)

Well No

Retain this copy for your office files.