

JEFF
P6
10-5-62

WATER WELL DRILLERS LOG

CODED

Date: 10-5, 1962 Driller: Chester Lewis (Name)

(1) Owner of Land: Earle M. Lusley
 (Name)
RFD, Fayette
 (Address)

(2) Location: $\frac{1}{4}$, $\frac{1}{4}$, Sec. 8 8 35
9 miles East of Fayette
 (distance) (direction) (nearest Town)

(3) Topography: Hilly
 (Hilly) (Flat) (Level)

(4) Purpose of Well: Domestic
 (Domestic Irrigation
 Municipal, Industrial, Other)

Description & Color of Materials Sand, Clay, Red Clay, Shell, etc	Thick- ness Feet	Depth Feet
<u>Dark grey & blue Chalk</u>	<u>15</u>	<u>115</u>
<u>white & blue chalk</u>	<u>15</u>	<u>130</u>
<u>Coarse white sand</u>	<u>20</u>	<u>15</u>

Information upon completion of well:

(1) Diameter 4 inches.

(2) Total Depth 150 feet.

(3) Water Level 120 feet below top of ground.

(4) Cased to bottom, Size 4"

(5) Screen: Size 4", Length 8'


(6) Were any formations sealed against pollution?
 _____ yes, no.

CODED

If YES depth of formation _____

Why _____

Drillers Remarks: old 2" well
rusty -

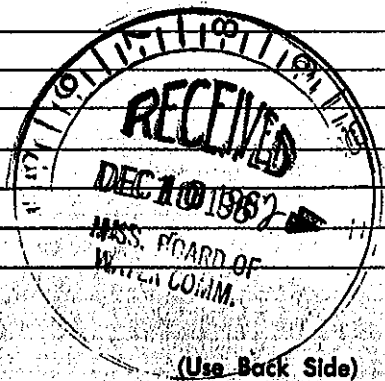

Well No.

all this copy to Board of Water Commissioners 429 Miss. St. Jackson, Miss