

**Jefferson WATER WELL DRILLERS LOG**

P 7

**CODED**

Date: 10-10-62, Driller: Chester Lee

DUNCAN EWEY (Name)

(1) Owner of Land: Jerry Duncan  
(Name)  
RFD, Fayette  
(Address)

(2) Location: 1/4, 1/4, Sec. 9 T8 R3E  
10 miles EAST of Fayette  
(distance) (direction) (Nearest Town)

(3) Topography: hilly  
(Hilly) (Flat) (Level)

(4) Purpose of Well: Domestic  
(Domestic Irrigation) (Municipal, Industrial, Other)

Description & Color of Materials Sand, Clay, Red Clay, Shell, etc.	Thick- ness Feet	Depth Feet
<u>hard gray limerock and thick chert</u>	<u>130</u>	<u>130</u>
<u>fine gray sand</u>	<u>20</u>	<u>150</u>
<u>white sand</u>	<u>18</u>	<u>168</u>

Information upon completion of well:

(1) Diameter: 4" inches.

(2) Total Depth: 168 feet.

(3) Water Level: 110 feet below top of ground.

(4) Cased to: bottom, Size \_\_\_\_\_

(5) Screen: Size 4", Length 8ft


(6) Were any formations sealed against pollution?  
 \_\_\_\_\_ yes,  no.

**CODED**

If YES depth of formation \_\_\_\_\_

Why \_\_\_\_\_

Drillers Remarks: gd well  
insufficient

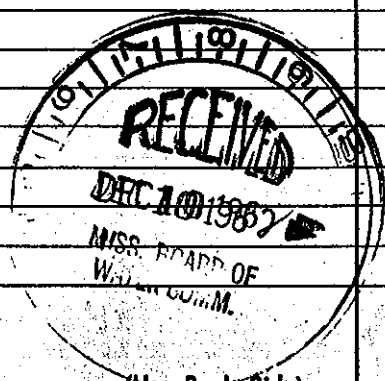

Well No. \_\_\_\_\_

Mail this copy to Board of Water Commissioners 429 Miss. St. Jackson, Miss