

Jeff. MISSISSIPPI BOARD OF WATER COMMISSIONERS

OPB
7-15-64

WATER WELL DRILLERS LOG

CODED

Date: 7-15, 1964, Driller: Chester Lewis County: Jefferson
(Name)

	Description & Color of Materials (Sand, Clay, Red Clay, Shell, etc.)	Thick- ness Feet	Depth Feet
(1) Owner of Land: <u>Mrs. Sarah J. DFD, Fayette - J</u> (Name) (Address)	<u>Red clay</u>	<u>20</u>	<u>20</u>
(2) Location: <u>7</u> miles <u>East</u> of <u>Fayette</u> (distance) (direction) (Nearest Town) Sec. <u>9</u> T. <u>8</u> R. <u>3E</u>	<u>Blue clay</u> <u>Coarse sand</u>	<u>120</u> <u>16</u>	<u>140</u> <u>156</u>
(3) Topography: <u>Hilly</u> (Hilly) (Flat) (Asph)			
(4) Purpose of Well: <u>Domestic</u> (Domestic Irrigation Municipal, Industrial, Other)			

Information upon completion of well:

(1) Diameter 4 inches.

(2) Total Depth 156 feet.

(3) Water Level 105 feet below top of ground.

(4) Cased to Batter size 4"

(5) Screen: Size 4", Length 7'


(6) Were any formations sealed against pollution?
_____ yes, no.

CODED

If YES depth of formation _____

Why _____

Drillers Remarks: never had a good well.

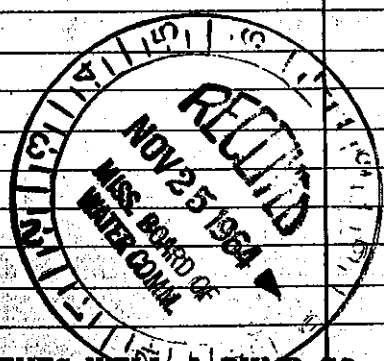

REEVES WELL & PUMP CO.
P. O. BOX 71 - PHONE 684-451
McCOMB, MISS.

Well No.

(Use Back Side)

Mail this copy to Board of Water Commissioners 429 Miss. St. Jackson, Miss.