
County: Jefferson Part 1	.4			
To Press of Part 1				
$C_{\text{output}} = 10 F 0 C 0 V 1 = 1 att 1$	For Office Use Only:			
Mississippi Department of Environm	ental Quality Aquifer:			
Permit #: Office of Land and Water Res				
P.O., Box 10631				
Driller: GRENN WATER WELL & P.O. Box 10631 SUPPLY, INC. Date drilling completed: 4/25/65 (601)961-5210	L. S. Elevation:			
Date drilling completed: <u>4/25/05</u> (601)961-5210	1			
(601)354-6938 (fax)	B-log #:			
State Law requires that this report be prepared by the driller in detail and filed with the Department within				
30 days of completion of drilling of the well. Well Owner Information	Well Location			
	0 37 503			
Dwner Name John Jones Latitude: 31	• $5730$ Longitude: $90^{\circ}3727$			
Owner Name_John Jones Mailing Address: 170 010 Jactson Rd 6x Hethod of Lat/Long (circle one): Conventional Survey,				
	quad, Hand-held GPS, Survey-grade GPS 3			
Terry MS 39170 City State Zip Code NW N	1/4 Sec 25 Twn 81 Rng HE			
City State Zin Code NUM N	W/ Siz			
Distance	Direction Nearest Town, les <u>Sw</u> of <u>Union Church</u>			
$\begin{array}{c} \text{Elephone No.} (60/) 954 - 1968 \\ \underline{4} \text{Mi} \end{array}$	les or <u>union chiqi ci</u>			
Well Data				
Purpose of Well (circle one) Home Industrial Public Supply Irrigation	Fish Culture Other: $\underline{\eta \mu / \tau \eta \mu c} \ c \ \omega m p$			
Date well drilling started: 4/25/05 Date well drilling completed: 4/25/05				
if flowing, method of flow regulation: Valve Other (describe)				
7,40	4/2010			
Static Water Level:				
Method of Measurement (circle one) steel tape electric tape air line other:				
Hole depth: <u>140</u> Well depth: <u>134</u> Well grouted to a depth of <u>10</u> feet				
Type of grout (circle one): Cement Bentonite Mix	<u>A</u>			
Casing length: <u>124</u> feet Casing diameter: <u>4</u> inches	Type of casing:			
Screen length:				
Screen slot size: <u>1010</u> inches Setting depth: From <u>124</u> feet to <u>134</u> feet				
Type of completion (circle all applicable): Gravel packed Underreamed Telescoped Open hole Natural Development				
Other (describe):				
Top of lap pipe or reduction in casing:feet. If telescoped or more than one screen, describe on back of page				
Logs run (circle all applicable): No log run Electric Gamma Ray Density S	Sonic Neutron Other:			
Name of organization running log(s):	·			
I certify that the well was drilled, constructed, and completed in accordance w	ith all applicable requirements of the Mississippi			
Department of Environmental Quality and/or the Mississippi Department of E				
when anythe at Variate Andreware Andreed and at the transmithe when anothe at the				
CDENNI WATED WELL & SUDDLY INC	ΛΙ			
GRENN WATER WELL & SUPPLY, INC.	on Misch ideal			
GRENN WATER WELL & SUPPLY, INC. Brian McClendon, lic. no. 0-664	Brian ME Clendor Signature of Water Well Contractor			

MAL 2 3 2005 BY: OLW R If well telescopes please sketch below and show depths.

12-17

Ground Level		Descrip	tion of Formations Encountered	From	To
· · · · · · · · · · · · · · · · · · ·		(ed c	ar	0	16
1		gravel	·	16	20
1			·	19	39
		red d	ay	20	25
	1	acnel	-	25	39
		white	day	39	48
•		Streak		48	123
		sand			
		white	Clay	/34	140
			·····		
· ·		· · · · ·	····		
			· · · · · · · · · · · · · · · · · · ·		
					<b>├</b> ───-┤
	. 1				<b> </b>
	-				

If more than one screen, show location of each on sketch

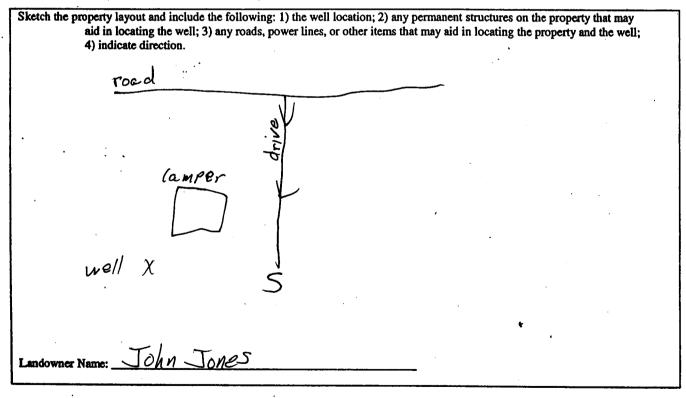

Brian McClendon, lic. no. 0-664 GRENN WATER WELL & SUPPLY, INC.

Signature of Water Well Contractor

STATE WELL REPORT				
County: Permit #:    Permit #:  Pump Installer's    Driller:  GRENN WATER WELL &  Mississippi Departmen    Driller:  GRENN WATER WELL &  P.O. E    SUPPLY, INC.  Jackson, M  (601)    Date completed:	art 2  For Office Use Only:    completion Report  Aquifer:    t of Environmental Quality  Aquifer:    Matter Resources  Well #:    S 39289-0631  Well #:    961-5210  Elevation:			
This report should be prepared by the pump installer in detai installation of pump.				
Well Owner Information	Well Location			
Owner Name: John Jones	Latitude: <u>W310,37 503 Longitude: W90,52 29</u> 7"			
Mailing Address: 1170 Old Jackson RdExt	Method of Lat/Long (circle one): Conventional Survey,			
	USGS quad Hand-held GPS, Survey-grade GPS			
Terry M5 39170 City State Zip Code	<u>SW14 SW14 Sec 25 Twn EN Rng 4E</u>			
City State Zip Code	Distance Direction Nearest Town			
Telephone No. (601) 954-1968	<u><u><u>H</u>Miles</u> <u>SW</u> of <u>Union</u> <u>Church</u></u>			
Ритр Туре	Power Type			
Circle one	Circle one			
Air Lift Jet Submersible	Diesel Engine Gasoline Engine Natural Gas			
Bucket Piston Turbine	Electric Motor Hand Tractor PTO			
Centrifugal Rotary Flowing Well	Windmill Other (specify):			
Other (specify):	Horse Power Rating of Motor:			
Date Pump Installed: 5/3/05	Setting Depth:			
Rated Pump Capacity:	Number of Stages: 1 2			
Pump Test Data	Method of Measuring Water Level			
Date Well Tested:5/3/05	Circle one			
Static Water Level (A): Feet Below Land Surface	Air Line Electric Measuring Line Steel Tape			
Pumping Water Level (B): <u>100</u> Feet Below Land Surface	Other (specify):			
Drawdown [(B) - (A)]: Feet Below Land Surface	For flowing well, measured shut in head:feet			
Test Pumping Rate: Gallons Per Minute ~	Well yielded GPM with a drawdown of			
Duration of Pump Test (minimum 4 hours): hours	10 feet after <u>4</u> hours of pumping			
	1			
I HEREBY CERTIFY that the above statements are true to the best of my knowledge. GRENN WATER WELL & SUPPLY, INC. William Hardin, lic. no. 0-717P William Hardin,				
Print Name of Pump Installer and License No. (if applicable)	Signature of Pump Installer			
	RECEIVE			

MAY 2 3 2005 BY: OLWR