

**JEFF. MISSISSIPPI BOARD OF WATER COMMISSIONERS**

P 2000

**WATER WELL DRILLERS LOG**

1-15-65

Date: 1-15, 1965, Driller: Chester Reeves & Pump Co. Jefferson County

(Name)

(1) Owner of Land: John B. Humphreys  
 Rt 1 - Union Church  
 (Name)  
 (Address)

Description & Color of Materials Sand, Clay, Red Clay, Shell, etc.	Thick- ness Feet	Depth Feet
Black top soil	10	10
Yellow sand	40	50
Grey shale	350	400
Fin Sand	64	464

(2) Location: 1/4, Sec. 3, R. 3 E  
 7 miles West Union Church  
 (distance) (direction) (Nearest Town)

(3) Topography: Hilly  
 (Hilly) (Flat) (Level)

(4) Purpose of Well: Domestic Use  
 (Domestic, Irrigation, Municipal, Industrial, Other)


**Information upon completion of well:**

- (1) Diameter: 4 1/2 inches.
- (2) Total Depth: 464 feet.
- (3) Water Level: 275 feet below top of ground.
- (4) Cased to: Bottom, Size: 2 1/2"
- (5) Screen: Size: 2", Length: 25'
- (6) Were any formations sealed against pollution?  
 yes,  no.

If YES depth of formation \_\_\_\_\_

Why \_\_\_\_\_

Drillers Remarks: New location

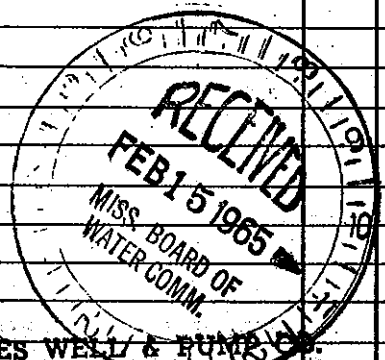

REEVES WELL & PUMP CO.  
 P. O. BOX 71 - PHONE 684-1461  
 McCOMB, MISS.

Well No.

(Use Back Side)