

A 7

A 7

**WATER WELL DRILLERS LOG**

1-2-64


Date: Jan 2, 1964, Driller: H. J. Macey County Jones  
(Name)

(1) Owner of Land:	Description & Color of Materials Sand, Clay, Red Clay, Shell, etc.	Thick- ness Feet	Depth Feet
<u>E. Watts</u> <small>(Name)</small> <u>Route # 7 Laurel</u> <small>(Address)</small>	<u>Chalk to 84'</u>		
<u>R 13W</u> <small>(Address)</small> <u>19N</u> <small>(Address)</small> <u>8</u> miles <u>West</u> of <u>Laurel</u> <small>(distance) (direction) (Nearest Town)</small>	<u>Fine mixed sand to 116'</u>		
(3) Topography: <u>None</u> <small>(Hilly) (Flat) (Level)</small>	<u>Last 5' med</u>		
(4) Purpose of Well: <u>None</u> <small>(Domestic Irrigation Municipal, Industrial, Other)</small>	<u>Course sand</u>		

Information upon completion of well:

- (1) Diameter 2 inches.
- (2) Total Depth 121 feet.
- (3) Water level 45' feet below top of ground.
- (4) Cased to \_\_\_\_\_, Size \_\_\_\_\_
- (5) Screen: Size #1 1/4 Length 5'
- (6) Were any formations sealed against pollution?  
 yes,  no.

If YES depth of formation \_\_\_\_\_  
 Why \_\_\_\_\_  
 Drillers Remarks: \_\_\_\_\_

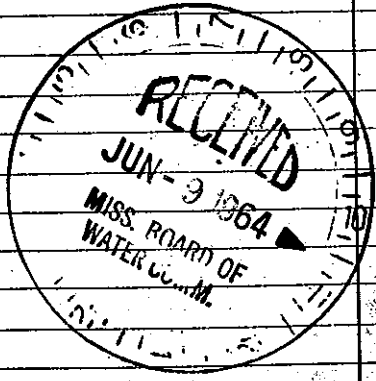

(Use Back Side)

Well No.