

JONES MISSISSIPPI BOARD OF WATER COMMISSIONERS

A8

A8

1-31-62

WATER WELL DRILLERS LOG

Date: Jan. 31, 1962, Driller: H. J. Mosey County: Jones
(Name)

(1) Owner of Land	Description & Color of Materials Sand, Clay, Red Clay, Shell, etc.	Thick- ness Feet	Depth Feet
<u>Meadow Hill</u> <small>(Name)</small> <u>Route #5 Laurel, Miss</u> <small>(Address)</small>			
(2) Location: <u>S 1/4, E 1/4, Sec 26 T10R13W</u> <u>2 1/2 miles North of Soso</u> <small>(distance) (direction) (Nearest Town)</small>			
(3) Topography: <u>(Hilly)</u> <u>(Flat)</u> <u>(Level)</u>			
(4) Purpose of Well: <u>Home use</u> <small>(Domestic Irrigation Municipal, Industrial, Other)</small>			

Sand to 153'
Clay to 194'
194' - 206'
Medium
course sand

Information upon completion of well:

(1) Diameter 2" inches.

(2) Total Depth 206 feet.


(3) Water Level 145' feet below top of ground.

(4) Cased to 36', Size 2"

(5) Screen: Size 1/4", Length 6'

(6) Were any formations sealed against pollution?
 _____ yes, no.

If YES depth of formation _____
 Why _____
 Drillers Remarks: _____

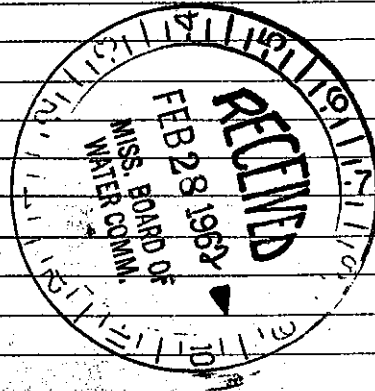

(Use Back Side)

Well No.