

MISSISSIPPI BOARD OF WATER COMMISSIONERS

JONES

A9

8-16-65

18  
23  
41

WATER WELL DRILLERS LOG

A91

Date: Aug 16, 1965, Driller: A. J. Moxey County: Jones  
(Name)

(1) Owner of Land:	Description & Color of Materials Sand, Clay, Red Clay, Shell, etc.	Thick- ness Feet	Depth Feet
(Name) <u>Early Gray</u>			
Pt # <u>2</u>			
(Address) <u>Taylorville</u>			
(Address) <u>34 T.T.N.</u>			
(2) Location: <u>1/4, 1/4, Sec. 7, T. 0 R. 14</u>			
<u>3</u> miles <u>South</u> , <u>Taylorville</u>	<u>Chalk to</u>		
(distance) (direction) (Nearest Town)	<u>19-ft fine</u>		
(3) Topography:	<u>sand to 54'</u>		
(Hilly) (Flat) (Level)	<u>last 10' medium</u>		
(4) Purpose of Well: <u>Home</u>	<u>Course</u>		
(Domestic Irrigation Municipal, Industrial, Other)			


Information upon completion of well:

- (1) Diameter 2 inches.
- (2) Total Depth 69 feet.
- (3) Water Level 50 feet below top of ground.
- (4) Cased to \_\_\_\_\_, Size \_\_\_\_\_.
- (5) Screen: Size 1/4, Length 5'.
- (6) Were any formations sealed against pollution?  
\_\_\_\_\_ yes, \_\_\_\_\_ no.

If YES depth of formation \_\_\_\_\_

Why \_\_\_\_\_

Drillers Remarks: \_\_\_\_\_

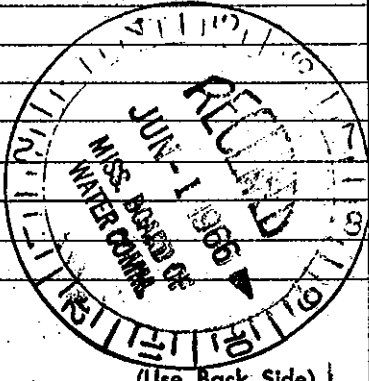

(Use Back Side) |

Well No. \_\_\_\_\_

Retain this copy for your office files.