

Jones  
A10  
10-65


MISSISSIPPI BOARD OF WATER COMMISSIONERS

WATER WELL DRILLERS LOG

A101

Date: 10/5, 1965, Driller: D. J. Macey County Jones  
(Name)

(1) Owner of Land	Description & Color of Materials Sand, Clay, Red Clay, Shell, etc.	Thick- ness Feet	Depth Feet
Northwest School (Name) Route #7 Laurel, Miss. (Address) 22 T 9 N			
(2) Location: 1/4, 1/4, Sec. T R 13 9 miles West of Laurel (distance) (direction) (Nearest Town)	Top surface to 51' sand, clay		
(3) Topography:	to 90' to 96'		
(4) Purpose of Well: School (Domestic Irrigation Municipal, Industrial, Other)	Medium blue rock & clay.		
Information upon completion of well:			
(1) Diameter 6 inches.	189' gray sand to 2'30" clay to 289' blue gray sand 35' of Med. Course.		
(2) Total Depth 423' 7" feet.			
(3) Water Level 180 feet below top of ground.	Balance depth		
(4) Cased to _____, Size _____	413' black clay		
(5) Screen: Size 4 .012, Length 41	462' bottom of drilling		
(6) Were any formations sealed against pollution? _____ yes, _____ no.			
If YES depth of formation _____			
Why _____			
Drillers Remarks: _____			

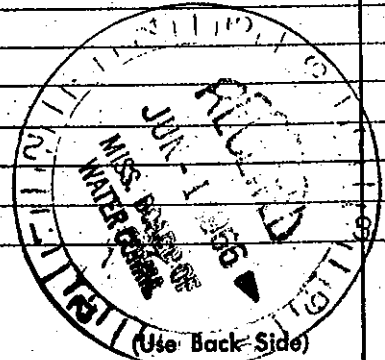

Well No.

Mail this copy to Board of Water Commissioners 429 Miss. St. Jackson, Miss.