

MISSISSIPPI BOARD OF WATER COMMISSIONERS

JONES

A 12

10-22-65

WATER WELL DRILLERS LOG

Date: 10/22, 1965, Driller: C.P. Clark County Jones

(Name)

(1) Owner of Land:	Description & Color of Materials Sand, Clay, Red Clay, Shell, etc.	Thick- ness Feet	Depth Feet
William B. Sasser (Name)	0-60 Sand	60	
Rt #1 Soso Miss (Address)	60-160 Clay	100	
(2) Location: 1/4, 1/4, Sec. 4 T9R13	160-184 Sand	24	
10 miles NW of Laurel (distance) (direction) (Nearest Town)			
(3) Topography: (Hilly) (Flat) (Level)			
(4) Purpose of Well: (Domestic, Irrigation, Municipal, Industrial, Other)			

Information upon completion of well:

(1) Diameter 2 inches.

(2) Total Depth 184 feet.

(3) Water Level 120 feet below top of ground.

(4) Cased to 179, Size 2


(5) Screen: Size 1 1/4, Length 555

(6) Were any formations sealed against pollution?
 yes, no.

If YES depth of formation _____

Why _____

Drillers Remarks: _____

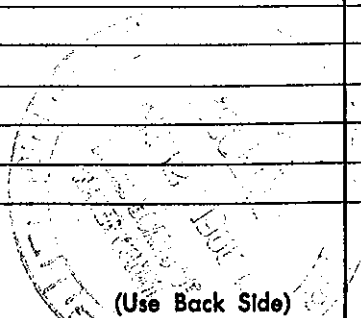

(Use Back Side)

Well No.

Mail this copy to Board of Water Commissioners 429 Miss. St. Jackson, Miss.