

~~CONFIDENTIAL~~ MISSISSIPPI BOARD OF WATER COMMISSIONERS

A14 (6)
5-21-65

WATER WELL DRILLERS LOG

JONES

Date: 5-21, 1965, Driller: Jay Lett County: Covington

Chicken House Hattiesburg (Name) Butane Gas Co.

(1) Owner of Land: M. J. Williams (Name)
Seminary mes. Rt. 3 (Address)

(2) Location: 1/4, 1/4, Sec. 19 T9N34W
10 miles NE of Seminary (distance) (direction) (Nearest Town)

(3) Topography: (Hilly) (Flat) (Level)

(4) Purpose of Well: Domestic (Domestic Irrigation, Municipal, Industrial, Other)

Description & Color of Materials Sand, Clay, Red Clay, Shell, etc.	Thick- ness Feet	Depth Feet
Red clay	0-7	
Red Sand	7-15	
gravel	15-20	
Red Sand	20-44	
white Sand	44-56	
yellow clay	56-75	
white clay	75-150	
blue clay	150-250	
blue Sand	250-280	

Information upon completion of well:

(1) Diameter 2" inches.

(2) Total Depth 280 feet.

(3) Water Level 138 feet below top of ground.

(4) Cased to _____, Size _____

(5) Screen: Size 2", Length 10'


(6) Were any formations sealed against pollution?
_____ yes, _____ no.

Location ??

If YES depth of formation _____

Why _____

Drillers Remarks: _____

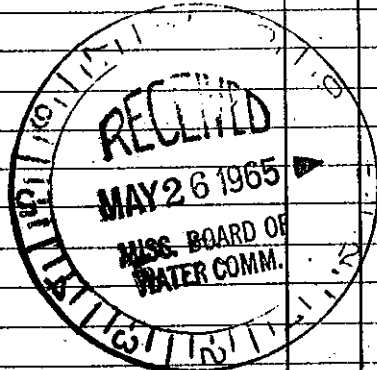

Well No.

(Use Back Side)