

JONES MISSISSIPPI BOARD OF WATER COMMISSIONERS

B 12 WATER WELL DRILLERS LOG

7-6-64

Date: 7/6, 1964, Driller: C. P. Clark County Jones

(Name)

(1) Owner of Land:	Description & Color of Materials Sand, Clay, Red Clay, Shell, etc.	Thick- ness Feet	Depth Feet
<u>Bush Dairy</u> (Name)	<u>0-40 Sandy Clay</u>	<u>40</u>	
<u>Laurel Miss</u> (Address)	<u>40-130 Clay</u>	<u>90</u>	
(2) Location: <u>NW 1/4, NW 1/4, Sec 24, T7 RD 4W</u>	<u>130-155 Sandy Clay</u>	<u>25</u>	
<u>1</u> miles <u>NW</u> of <u>Laurel</u> (distance) (direction) (Nearest Town)	<u>155-195 Sand</u>	<u>40</u>	
(3) Topography: <u>Hilly</u> (Hilly) (Flat) (Level)			
(4) Purpose of Well: <u>Industrial</u> (Domestic Irrigation Municipal, Industrial, Other)			


Information upon completion of well:

- (1) Diameter 4 inches.
- (2) Total Depth 195 feet.
- (3) Water Level 95 feet below top of ground.
- (4) Cased to 175, Size 4 in
- (5) Screen: Size 3 3/4 in, Length 20
- (6) Were any formations sealed against pollution?
 yes, no.

If YES depth of formation _____

Why _____

Drillers Remarks: _____

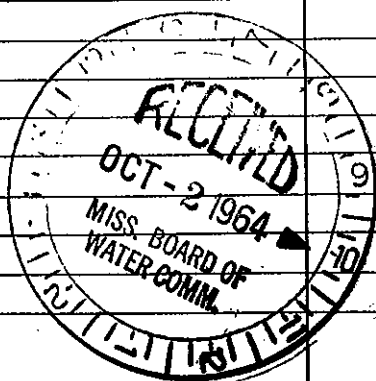

(Use Back Side)

Well No. _____

Mail this copy to Board of Water Commissioners 429 Miss. St. Jackson, Miss.