

JONES MISSISSIPPI BOARD OF WATER COMMISSIONERS

B 30
11-7-63

WATER WELL DRILLERS LOG

Date: 11-7, 1963 Driller: H. J. Moxey County Jones
 (Name)

(1) Owner of Land	Description & Color of Materials Sand, Clay, Red Clay, Shell, etc.	Thick- ness Feet	Depth Feet
<u>L. B. Bynum</u> (Name)			
<u>Route #5 Laurel</u> (Address)	<u>Sand from</u>		
Location: <u>Sec 7</u> , <u>T 9 N</u> , <u>R 12 W</u> 1/4, 1/4, Sec. T R	<u>top to</u>		
<u>5</u> miles <u>West</u> of <u>Laurel</u> (distance) (direction) (Nearest Town)	<u>bottom 60'</u>		
(3) Topography: <u>Flat</u> (Hilly) (Flat) (Level)			
(4) Purpose of Well: <u>Name</u> (Domestic Irrigation Municipal, Industrial, Other)			


Information upon completion of well:

- (1) Diameter 2 inches.
- (2) Total Depth 60 feet.
- (3) Water Level 35 feet below top of ground.
- (4) Cased to _____, Size _____
- (5) Screen: Size 1 1/4, Length 3'
- (6) Were any formations sealed against pollution?
 _____ yes, _____ no.

If YES depth of formation _____

Why _____

Drillers Remarks: _____

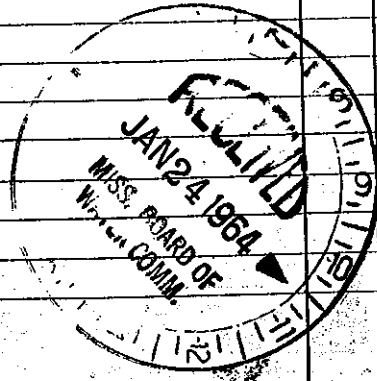

(Use Back Side)

Well No.