

MISSISSIPPI BOARD OF WATER COMMISSIONERS

WATER WELL

Date: Jan 13, 1965, Driller: A. J. Moley County Jones

(1) Owner of Land: J. T. Shaws
(Name)
Assoc, Miss
(Address) 18. T. 9 N. 2 W.
(2) Location: 1/4, 1/4, Sec. T. R.
3 miles East, of Assoc
(distance) (direction) (Nearest Town)
(3) Topography: Level
(Hilly) (Flat) (Level)
(4) Purpose of Well: Home
(Domestic Irrigation)
Municipal, Industrial, Other)

Description & Color of Materials Sand, Clay, Red Clay, Shell, etc.	Thick- ness Feet	Depth Feet
<u>Med blue</u>		
<u>sand & clay</u>		
<u>to 70' ROP</u>		
<u>from 70' to</u>		
<u>75' Clay & fine</u>		
<u>sand to 150'</u>		
<u>Good Course</u>		
<u>sand to 173'</u>		


Information upon completion of well:

- (1) Diameter 2 inches.
(2) Total Depth 173 feet.
(3) Water Level 96 feet below top of ground.
(4) Cased to _____, Size _____
(5) Screen: Size 1/4, Length 6'
(6) Were any formations sealed against pollution?
yes, no.

If YES depth of formation _____

Why _____

Drillers Remarks: _____

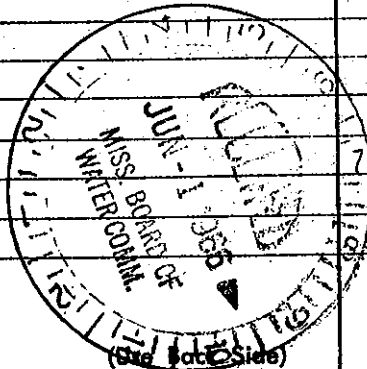

Well No. _____

Mail this copy to Board of Water Commissioners 429 Miss. St. Jackson, Miss