

JONES

MISSISSIPPI BOARD OF WATER COMMISSIONERS

B 33


WATER WELL DRILLERS LOG

6-27-66

Date: June 27, 1966, Driller: H. J. May County Jones
(Name)

(1) Owner of Land	Description & Color of Materials Sand, Clay, Red Clay, Shell, etc.	Thick- ness Feet	Depth Feet
<u>A. L. Sharp</u> (Name) <u>Route #5 Laurel</u> (Address)			
(2) Location: <u>29 R124 T9N</u> 1/4, 1/4, Sec. T R	<u>Clay down to</u>		
<u>7 miles West of Laurel</u> (distance) (direction) (Nearest Town)	<u>first 10' from</u>		
(3) Topography: <u>Flat</u> (Hilly) (Flat) (Level)	<u>then on</u>		
(4) Purpose of Well: <u>Home</u> (Domestic Irrigation Municipal, Industrial, Other)	<u>Med. Course</u>		
Information upon completion of well:			
(1) Diameter <u>2</u> inches.			
(2) Total Depth <u>69</u> feet.			
(3) Water Level <u>58</u> feet below top of ground.			
(4) Cased to _____, Size _____			
(5) Screen: Size <u>1/4</u> , Length <u>5'</u>			
(6) Were any formations sealed against pollution? _____ yes, <input checked="" type="checkbox"/> no.			
If YES depth of formation _____			
Why _____			
Drillers Remarks: _____			

Clay down to first 10' from then on Med. Course to 69'

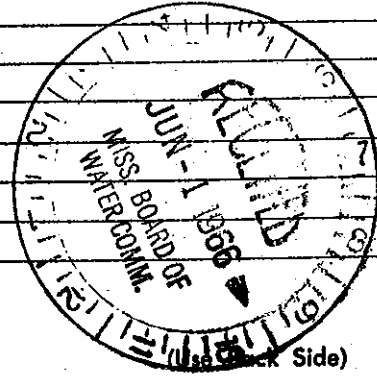

Well No.