

MISSISSIPPI BOARD OF WATER COMMISSIONERS

WATER WELL DRILLERS LOG

Date: 9/25, 1963, Driller: C. J. Clark County Jones
 (Name)

(1) Owner of Land: Hershell L. Clark
 (Name)
Rt #3 Laurel Miss
 (Address)
 (2) Location: 1/4, 1/4, Sec. 11, T9R12
2 miles NW of Laurel
 (distance) (direction) (Nearest Town)
 (3) Topography: X
 (Hilly) (Flat) (Level)
 (4) Purpose of Well: Domestic
 (Municipal, Irrigation, Industrial, Other)


Description & Color of Materials Sand, Clay, Red Clay, Shell, etc.	Thick- ness Feet	Depth Feet
<u>0-85 Clay</u>	<u>85</u>	
<u>85-120 Sand</u>	<u>35</u>	
<u>120-180 Clay</u>	<u>60</u>	
<u>180-189 Sand</u>	<u>9</u>	
<u>189-220 Sand</u>	<u>31</u>	
<u>220-225 Clay</u>	<u>05</u>	
<u>225-240 Sand</u>	<u>15</u>	
<u>240-278 Sand</u>	<u>38</u>	

Information upon completion of well:

(1) Diameter 2 inches.
 (2) Total Depth 278 feet.
 (3) Water Level 110 feet below top of ground.
 (4) Cased to 268, Size 2 in
 (5) Screen: Size 1/4, Length 10
 (6) Were any formations sealed against pollution?
 yes, no.

If YES depth of formation 210 ft
 Why Seal off Red Water

Drillers Remarks:

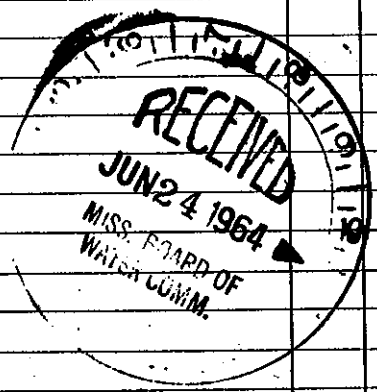

(Use Back Side)

Well No.