

Jones
B42
7-68

MISSISSIPPI
 BOARD OF WATER COMMISSIONERS
 416 North State Street
 Jackson, Mississippi 39201

CODED

WATER WELL DRILLERS LOG


7-24 *1968* *Herstell Taylor Water Well Drilling* *Jones*
 date well completed Route ~~One~~ *One* Phone *763-3367* county well located

LANDOWNER: <i>Allen Lewis</i>	Ellisville, Miss. 39437	description of formations encountered	from	to
<i>st. 5</i>		<i>white sand</i>	<i>0</i>	<i>15'</i>
<i>Samuel, Miss</i>		<i>blue chalk</i>	<i>15'</i>	<i>24'</i>
(mailing address)		<i>fine sand</i>	<i>24'</i>	<i>30'</i>
		<i>course sand</i>	<i>30'</i>	<i>38'</i>

WELL LOCATION:
 sec. *33* T *9* N R. *12* E
4 miles *West* of *Samuel*
 (distance) (direction) (nearest town)

WELL PURPOSE: *home*
 (home, irrigation, municipal, industrial)

- WELL COMPLETION DATA:
- (1) diameter (inches) *2"*
 - (2) total depth (feet) *38'*
 - (3) static water level (feet) *20'* below top of ground.
 - (4) casing *plastic* *35'*
 (material) (depth)
2" If telescope see back.
 (size)
 - (5) screen *35'* *35'*
 (length) (depth to top)
2" *3/5*
 (size) (material)
 - (6) pump *1/2* *600 gpm*
 (HP) (yield gpm)
Electric
 (type power)
 - (7) electric log (yes or no)
 - (organization running log)
 - (8) how well bottom plugged *w/ valve*

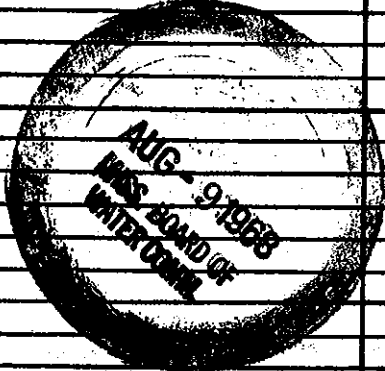

DRILLERS REMARKS: