

MISSISSIPPI DEPARTMENT OF NATURAL RESOURCES

Bureau of Land and Water Resources

Southport Mall

P.O. Box 40631


Jackson, Mississippi 39209

WATER WELL DRILLERS LOG

CODED

FEB 1981

CODED

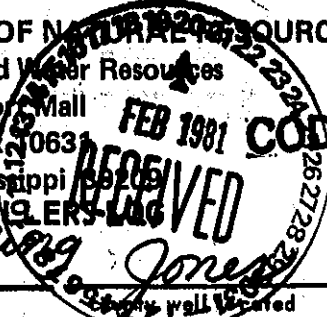

JONES
B 77
1/8/81

1-8-81 date well completed
Gunn Drilling Service, Inc. firm name

LANDOWNER:
Pennzoil Producing Co
P.O. Box 6088
Shreveport, La 71106
(mailing address)

| description of formations encountered | from | to |
|---------------------------------------|------|-----|
| clay and sand | 0 | 350 |
| sand & gravel | 350 | 406 |

WELL LOCATION: 2040'S + 1255E
Helmets T-9 R-12 of
Walter #1 of Newcom
#1 miles (direction) of (nearest town)

WELL PURPOSE: oil field
(home, irrigation, municipal supply)

WELL COMPLETION DATA:

- (1) diameter (inches) 3"
- (2) total depth (feet) 406'
- (3) static water level (feet) 80' ^{below} top of ground
- (4) casing Steel, 406'
(material) (depth)
3" (size) If telescope see back.
- (5) screen 42', 364'
(length) (depth to top)
3" perforated
(size) (material)
- (6) pump 75
(HP) (yield gpm)
ac
(type power)
- (7) electric log —
(yes or no)
(organization running log)
- (8) how well bottom plugged orange
peel

DEPT. OF NATURAL RESOURCES
BUREAU OF LAND & WATER RESOURCES

FEB 20 1981

RECEIVED

DRILLERS REMARKS: