


**JONES MISSISSIPPI BOARD OF WATER COMMISSIONERS**

**C6 - C6**  
**10-2-63**

**WATER WELL DRILLERS LOG**

Date: 10/2, 1963, Driller: C.P. Clark County Jones  
(Name)

(1) Owner of Land:	Description & Color of Materials Sand, Clay, Red Clay, Shell, etc.	Thick- ness Feet	Depth Feet
<u>Grady Hamilton</u> (Name)	<u>0-18 Grey Clay</u>	<u>18</u>	
<u>Rt #3 Laurel Miss</u> (Address)	<u>18-28 yellow Sand</u>	<u>10</u>	
(2) Location: <u>SE 1/4, SE 1/4, Sec. 6, T7N, R11W</u>	<u>28-31 Pink Chalk</u>	<u>03</u>	
<u>3</u> miles <u>North</u> of <u>Laurel</u> (distance) (direction) (Nearest Town)	<u>31-40 Grey Clay</u>	<u>9</u>	
(3) Topography: <input checked="" type="checkbox"/> (Hilly) <input type="checkbox"/> (Flat) <input type="checkbox"/> (Level)	<u>40-116 Sand</u>	<u>76</u>	
(4) Purpose of Well: <input type="checkbox"/> (Domestic Irrigation) <input type="checkbox"/> (Municipal) <input type="checkbox"/> (Industrial) <input type="checkbox"/> (Other)	<u>116-165 Clay</u>	<u>49</u>	
Information upon completion of well:	<u>165-206 Clay</u>	<u>41</u>	
(1) Diameter <u>4</u> inches.	<u>206-217 Sand</u>	<u>11</u>	
(2) Total Depth <u>217</u> feet.			
(3) Water Level <u>160</u> feet below top of ground.			
(4) Cased to <u>200</u> , Size <u>4 in</u>			
(5) Screen: Size <u>3 3/4</u> , Length <u>17</u>			
(6) Were any formations sealed against pollution? <input checked="" type="checkbox"/> yes, <input type="checkbox"/> no.			
If YES depth of formation <u>200</u>			
Why <u>Deal upper water</u>			
Drillers Remarks:			

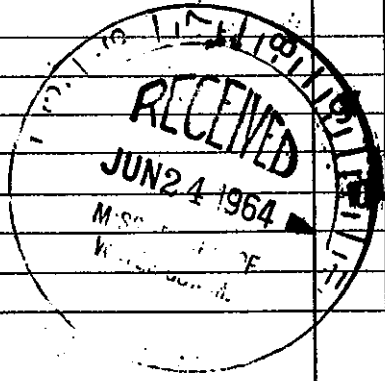

(Use Back Side)

Well No.

Mail this copy to Board of Water Commissioners 429 Miss. St. Jackson, Miss