

JONES MISSISSIPPI BOARD OF WATER COMMISSIONERS

C 47
8-2-60

WATER WELL DRILLERS KOG
WATER WELL DRILLING
ROUTE TWO

Date: 8/3, 1960, Driller: LAUREL, MISS. County Jones
(Name)

(1) Owner of Land: Chris Brown
(Name)
Qt #2 Laurel Miss
(Address)

(2) Location: 1/4, 1/4, Sec 29 T10 R11W
5 miles North of Laurel
(distance) (direction) (Nearest Town)

(3) Topography: X
(Hilly) (Flat) (Level)

(4) Purpose of Well: Domestic
(Domestic Irrigation
Municipal, Industrial, Other)


Description & Color of Materials Sand, Clay, Red Clay, Shell, etc.	Thick- ness Feet	Depth Feet
0-20 Clay	20	
20-21 Sand	1	
21-37 Clay	16	
37-42 Sand	5	
42-70 Clay	28	
70-85 Sand	15	
85-100 blue Clay	15	

Information upon completion of well:

- (1) Diameter 2 inches.
- (2) Total Depth 85 feet.
- (3) Water Level 21 feet below top of ground.
- (4) Cased to 73, Size 02
- (5) Screen: Size 1/4, Length 12
- (6) Were any formations sealed against pollution?
_____ yes, X no.

If YES depth of formation _____
Why _____

Drillers Remarks: Heavy 11 North
to Heavy Scales
1st Right 2nd House
on left

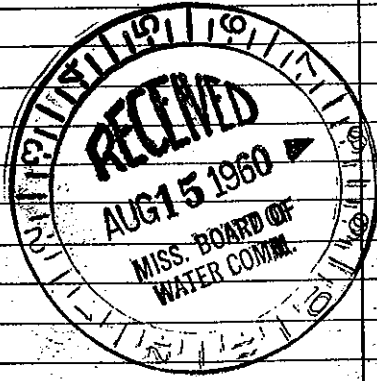

(Use Back Side)

Well No.