

MISSISSIPPI BOARD OF WATER COMMISSIONERS

JONES

WATER WELL DRILLERS LOG

Jones Co.?

49
8-18-60

Date: 8-18, 1960, Driller: Walter Hunter County Marion

(Name)

(1) Owner of Land: C. Z. Hunter
(Name)

Description & Color of Materials
Sand, Clay, Red Clay, Shell, etc.

Thick-
ness
Feet

Depth
Feet

Laurel, Mississippi
(Address)

Top Soil
Clay
Sand

15' 15'
150' 165'
28' 193'

(2) Location: 1/4, 1/4, Sec. 12 T 9N R 11W

4 miles N.E., of Laurel
(distance) (direction) (Nearest Town)

(3) Topography: X
(Hilly) (Flat) (Level)

(4) Purpose of Well: Domestic
(Domestic Irrigation
Municipal, Industrial, Other)


Information upon completion of well:

- (1) Diameter 2 inches.
- (2) Total Depth 196 feet.
- (3) Water Level 80 feet below top of ground.
- (4) Cased to 189', Size 2"
- (5) Screen: Size 2", Length 5'
- (6) Were any formations sealed against pollution?
_____ yes, _____ no.

If YES depth of formation _____

Why _____

Drillers Remarks: _____

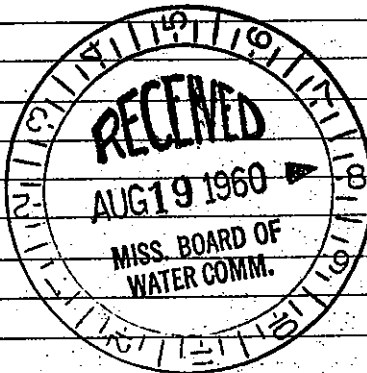

Well No. 2

(Use Back Side)

Mail this copy to Board of Water Commissioners 429 Miss. St. Jackson, Miss.