

JONES MISSISSIPPI BOARD OF WATER COMMISSIONERS

WATER WELL DRILLERS LOG

C. P. CLARK

WATER WELL DRILLING

County Jones

Date: 9/23, 1960, Driller:

**ROUTE TWO
LAUREL, MISS.**

(1) Owner of Land: Janice Chandler
(Name)
Rt # 6 Laurel Miss
(Address)

Description & Color of Materials Sand, Clay, Red Clay, Shell, etc.	Thick- ness Feet	Depth Feet
<u>0-80 Clay</u>	<u>80</u>	
<u>80-105 Sand</u>	<u>25</u>	
<u>105-160 Clay</u>	<u>55</u>	
<u>160-190 Sand</u>	<u>30</u>	
<u>190-260 Clay</u>	<u>70</u>	
<u>260-298 Sand</u>	<u>38</u>	

(2) Location: 1/4, 1/4, Sec. 24 ^N ^{R 11W}
5 miles East, of Laurel
(distance) (direction) (Nearest Town)

(3) Topography: (Hilly) (Flat) (Level)

(4) Purpose of Well: Domestic
(Domestic Irrigation
Municipal, Industrial, Other)


Information upon completion of well:

- (1) Diameter 2 inches.
- (2) Total Depth 298 feet.
- (3) Water Level 110 feet below top of ground.
- (4) Cased to 292, Size 2
- (5) Screen: Size 1/4, Length 6ft
- (6) Were any formations sealed against pollution?
 yes, no.

If YES depth of formation _____

Why _____

Drillers Remarks: Property Gains
Powers School of
South Side

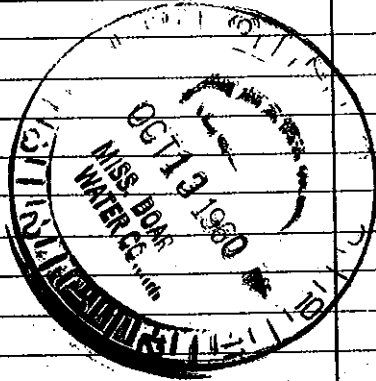

(Use Back Side)

Well No. _____