

MISSISSIPPI BOARD OF WATER COMMISSIONERS

WATER WELL DRILLERS LOG

JONES

C 52 1/2  
10-28-60

Jones

Date: 10-28, 1960, Driller: W. K. Barnes County: Jasper

(Name)

(1) Owner of Land:	Description & Color of Materials Sand, Clay, Red Clay, Shell, etc.	Thick- ness Feet	Depth Feet
Eretta Baptist Church (Name)	Red Clay	0	15
Laurel Route (Address)	yellow clay	25	40
	water sand	40	77

(2) Location: 1/4, 1/4, Sec. 29 T10R11W

5 miles north of Laurel  
(distance) (direction) (Nearest Town)

(3) Topography: Hilly  
(Hilly) (Flat) (Level)

(4) Purpose of Well: Church  
(Domestic Irrigation  
Municipal, Industrial, Other)

Information upon completion of well:

(1) Diameter 2 inches.

(2) Total Depth 57 feet.

(3) Water Level 30 feet below top of ground.

(4) Cased to 0-1, Size 2


(5) Screen: Size 80, Length 6

(6) Were any formations sealed against pollution?  
yes, no.

If YES depth of formation

Why

Drillers Remarks:

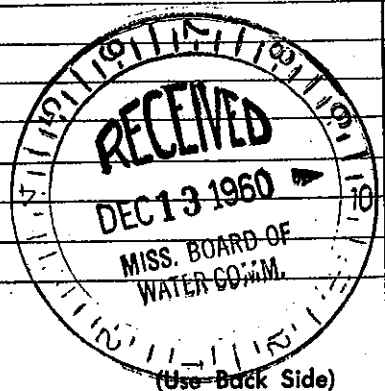

Well No.

Mail this copy to Board of Water Commissioners 429 Miss. St. Jackson, Miss