

JONES

MISSISSIPPI BOARD OF WATER COMMISSIONERS

C 57
3-29-62

WATER WELL DRILLERS LOG

Date: 3/29, 1962, Driller: C.P. Clark County Jones


(Name)

	Description & Color of Materials Sand, Clay, Red Clay, Shell, etc.	Thick- ness Feet	Depth Feet
(1) Owner of Land: Hasbell Pearson	0-17 red clay	17	
(Name) Rt 6 Laurel Miss	17-102 blue clay	85	
(Address)	102-140 sand	38	
(2) Location: 1/4, 1/4, Sec. 36 T. 9N R. 11W	140-252 Blue Clay	12	
4 miles East of Laurel	252-287 Blue Sand	35	
(distance) (direction) (Nearest Town)			
(3) Topography: <input checked="" type="checkbox"/> (Hilly) <input type="checkbox"/> (Flat) <input type="checkbox"/> (Level)			
(4) Purpose of Well:			
(Domestic, Irrigation, Municipal, Industrial, Other)			

Information upon completion of well:

- (1) Diameter 2 inches.
- (2) Total Depth 287 feet.
- (3) Water Level 105 feet below top of ground.
- (4) Cased to 277, Size 2
- (5) Screen: Size 1 1/4, Length 10
- (6) Were any formations sealed against pollution?
 yes, no.

If YES depth of formation _____
Why _____
Drillers Remarks: _____

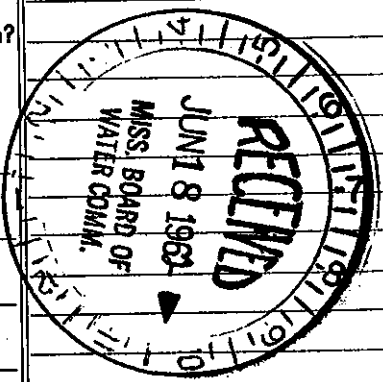

(Use Back Side)

Well No.