

ONES

MISSISSIPPI BOARD OF WATER COMMISSIONERS

C 58


5-22-62

WATER WELL DRILLERS LOG

Date: 5/22, 1962, Driller: C.P. Clark County Jones

(Name)

	Description & Color of Materials Sand, Clay, Red Clay, Shell, etc.	Thick- ness Feet	Depth Feet
(1) Owner of Land: <u>Sears Ward</u> (Name) <u>Rt 2 Laurel Miss</u> (Address)	0-17 Sandy Clay	17	
	17-42 Blue Clay	25	
	42-89 Sand	47	
(2) Location: $\frac{1}{4}$, $\frac{1}{4}$, Sec. <u>12</u> T. <u>9</u> R. <u>11</u> <u>5</u> miles <u>NE</u> of <u>Laurel</u> (distance) (direction) (Nearest Town)			
(3) Topography: <input checked="" type="checkbox"/> (Hilly) <input type="checkbox"/> (Flat) <input type="checkbox"/> (Level)			
(4) Purpose of Well: <input checked="" type="checkbox"/> Domestic, Irrigation <input type="checkbox"/> Municipal, Industrial, Other			
Information upon completion of well:			
(1) Diameter <u>2</u> inches.			
(2) Total Depth <u>89</u> feet.			
(3) Water Level <u>55</u> feet below top of ground.			
(4) Cased to <u>84</u> , Size <u>2</u>			
(5) Screen: Size <u>1/4</u> , Length <u>6</u>			
(6) Were any formations sealed against pollution? <u>no.</u>			
If YES depth of formation _____			
Why _____			
Drillers Remarks: _____			

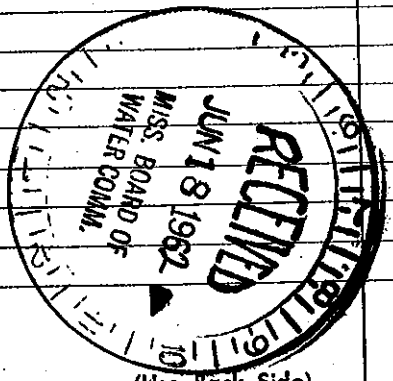

Well No.

Mail this copy to Board of Water Commissioners 429 Miss. St. Jackson, Miss