

JONES
C 63

MISSISSIPPI BOARD OF WATER COMMISSIONERS

1-18-63 WATER WELL DRILLERS LOG


Date: 1/18, 1963, Driller: G.P. Clark County Jones
(Name)

(1) Owner of Land:	Description & Color of Materials Sand, Clay, Red Clay, Shell, etc.	Thick- ness Feet	Depth Feet
Johnnie Stephens (Name) Rt 3 Laurel Miss (Address)	0-15 Clay	15	
(2) Location: 1/4, 1/4, Sec. 8, T. 9 N, R. 11 W	15-74 Sand	59	
2 miles North of Laurel (distance) (direction) (Nearest Town)			
(3) Topography:			
(4) Purpose of Well: Chicken House (Domestic Irrigation Municipal, Industrial, Other)			

Information upon completion of well:

- (1) Diameter 2 inches.
- (2) Total Depth 74 feet.
- (3) Water Level 17 feet below top of ground.
- (4) Cased to 69, Size 2 in.
- (5) Screen: Size 1 1/4, Length 5.
- (6) Were any formations sealed against pollution?
yes, no.

If YES depth of formation _____
Why _____
Drillers Remarks: _____

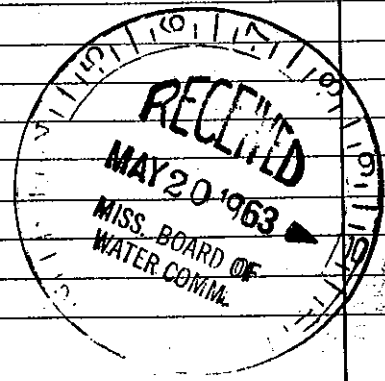

(Use Back Side)

Well No.