

JONES

MISSISSIPPI BOARD OF WATER COMMISSIONERS

C 64

3-1-63

WATER WELL DRILLERS LOG

Date: 3/1, 1963, Driller: G.P. Clark County Jones

(1) Owner of Land: Mrs. Lillian Smith (Name)
 Rt #2 Laurel Miss. (Address)

(2) Location: 1/4, 1/4, Sec. 28 NW
 7 miles North of Laurel (distance, direction, Nearest Town)

(3) Topography: (Hilly) (Flat) (Level)

(4) Purpose of Well: Domestic (Domestic Irrigation, Municipal, Industrial, Other)

Description & Color of Materials Sand, Clay, Red Clay, Shell, etc.	Thick- ness Feet	Depth Feet
0-75 Clay	75	
75-130 Sand	55	


Information upon completion of well:

- (1) Diameter 2 inches.
- (2) Total Depth 132 feet.
- (3) Water level 85 feet below top of ground.
- (4) Cased to 126, Size 2 in.
- (5) Screen: Size 1/4, Length 6 ft.
- (6) Were any formations sealed against pollution?
 yes, no.

If YES depth of formation _____

Why _____

Drillers Remarks: _____

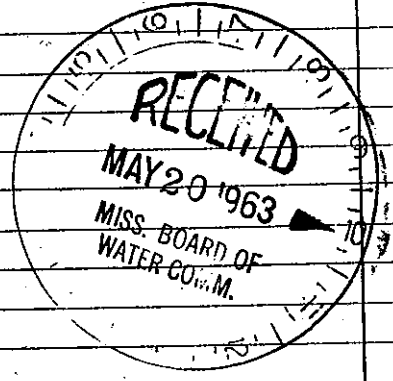

Well No.

(Use Back Side)

Mail this copy to Board of Water Commissioners 429 Miss. St. Jackson, Miss.