

JONES MISSISSIPPI BOARD OF WATER COMMISSIONERS

C 165
5-4-63

WATER WELL DRILLERS LOG


✓ 14

Date: 5-4, 1963, Driller: H. J. May County Jones
(Name)

(1) Owner of Land: <u>O. V. Clark</u> (Name)	Description & Color of Materials Sand, Clay, Red Clay, Shell, etc.	Thick- ness Feet	Depth Feet
<u>Route #2 Laurel</u> (Address)	<u>Chalk to</u>		
(2) Location: <u>1/4, 1/4, Sec. 7, T. 11, R. 11, 32</u> <u>3</u> miles <u>North</u> , of <u>Laurel</u> (distance) (direction) (Nearest Town)	<u>65' fine</u> <u>sand to 70'</u>		
(3) Topography: <input checked="" type="checkbox"/> (Hilly) <input type="checkbox"/> (Flat) <input type="checkbox"/> (Level)	<u>Med course</u>		
(4) Purpose of Well: <u>Home use</u> (Domestic Irrigation, Municipal, Industrial, Other)	<u>to 78 ft.</u>		

Information upon completion of well:

- (1) Diameter 2" inches.
 - (2) Total Depth 78 feet.
 - (3) Water Level 45 feet below top of ground.
 - (4) Cased to _____, Size _____.
 - (5) Screen: Size 1 1/4, Length 6'.
 - (6) Were any formations sealed against pollution?
_____ yes, _____ no.
- If YES depth of formation _____
- Why _____
- Drillers Remarks: _____

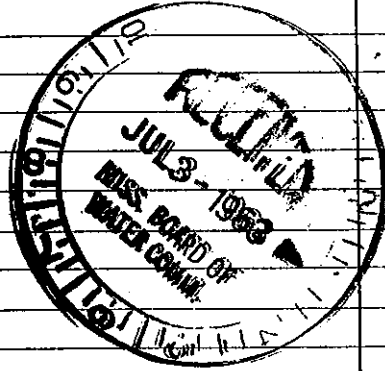

Well No.

(Use Back Side)

Mail this copy to Board of Water Commissioners 429 Miss. St. Jackson, Miss