

C. P. CLARK
WATER WELL DRILLING
 ROUTE 2

MISSISSIPPI LAUREL, MISS. 39440
 BOARD OF WATER COMMISSIONERS
 416 North State Street
 Jackson, Mississippi 39201

WATER WELL DRILLERS LOG

JONES
 C66
 12-67

12/28 1967 C.P. Clark Jones
 date well completed firm name county well located


LANDOWNER: City of Sandersville Miss
same
 (mailing address)

WELL LOCATION:
 sec. 1 T. 9 N. R. 11 E.
in City of Sandersville
 (distance) (direction) (nearest town)

WELL PURPOSE:
 (home, irrigation, municipal, industrial)

WELL COMPLETION DATA:
 (1) diameter (inches) 6 x 4
 (2) total depth (feet) 181
 (3) static water level (feet) 75 below top of ground.
 (4) casing Galvbron 120,
 (material) (depth)
4 if telescope see back.
 (size)
 (5) screen 20 120+161
 (length) (depth to top)
4 304-S.S.
 (size) (material)
 (6) pump 1 1/2 110
 (HP) (yield gpm)
220V 3 Phase
 (type power)
 (7) electric log No
 (yes or no)
 (organization running log)
 (8) how well bottom plugged B.W.U

description of formations encountered	from	to
Red. Clay	0	10
Yellow Sand	10	17
Blue Clay	17	37
Sandy Clay	37	57
Hard Clay	57	65
Sandy Clay	65	78
Blue Hard Clay	78	117
Sandy Clay	117	120
Thin Green Sand	120	130
Sandy Clay	130	142
Hard Clay	142	154
Clay + Shells	154	158
Hard Clay	158	171
Sand + Shells	171	177
Rock	177	178 1/2
Sand + Shells	178 1/2	181

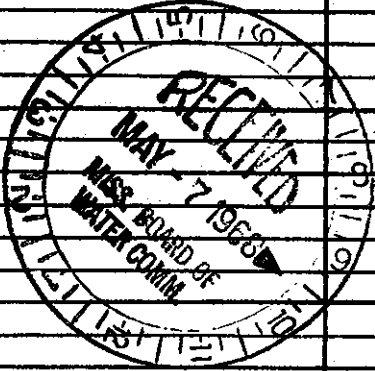

DRILLERS REMARKS: