

JONES

MISSISSIPPI BOARD OF WATER COMMISSIONERS

C 68

6-28-62

WATER WELL DRILLERS LOG

Date: 6/28, 1962, Driller: C.P. Clark County Jones

(1) Owner of Land: A.B. Bunch
 (Name)
Rt #6 Laurel Miss
 (Address)

(2) Location: 1/4, 1/4, Sec. 36 N R11W
4 miles East of Laurel
 (distance) (direction) (Nearest Town)

(3) Topography: (Hilly) (Flat) (Level)

(4) Purpose of Well: _____
 (Domestic, Irrigation, Municipal, Industrial, Other)

Description & Color of Materials Sand, Clay, Red Clay, Shell, etc.	Thick- ness Feet	Depth Feet
0-20 red clay	20	
20-80 grey clay	60	
80-111 sand	31	
111-149 Blue Clay	38	
149-160 sand	11	

Information upon completion of well:

(1) Diameter 2 inches.

(2) Total Depth 160 feet.

(3) Water Level 65 feet below top of ground.

(4) Cased to 150, Size 2


(5) Screen: Size 1/4, Length 10

(6) Were any formations sealed against pollution?
 _____ yes, no.

If YES depth of formation _____

Why _____

Drillers Remarks: _____

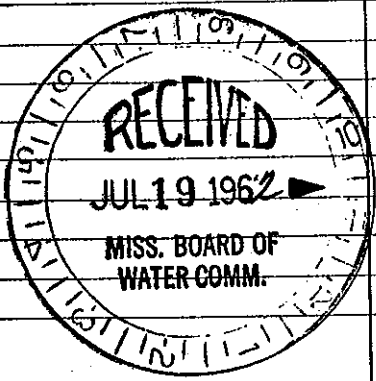

(Use Back Side)

Well No.