

**WATER WELL DRILLERS LOG**


JONES  
C 70  
12-63

Date: Dec. 1963, Driller: Peoples Drilling Co. County Jasper  
(Name)

	Description & Color of Materials Sand, Clay, Red Clay, Shell, etc.	Thick- ness Feet	Depth Feet
(1) Owner of Land: <u>Miller Myrick</u> (Name)	0-12 Red CLAY		
<u>RT. 1 Heidelberg Miss</u> (Address)	12-52 Red clay & white Chalk		
(2) Location: <u>1/4</u> , <u>1/4</u> , Sec. <u>32 T10N R11W</u>	52-73 Blue Marl		
<u>4</u> miles <u>West</u> , of <u>Sandersville</u> (distance) (direction) (Nearest Town)	73-115 yellow SAND		
(3) Topography: <u>Hilly</u> (Hilly) (Flat) (Level)	115-231 Grey shale		
(4) Purpose of Well: <u>Domestic</u> (Domestic Irrigation Municipal, Industrial, Other)	231-294 white lime		
	294-325 Gumbo		
	325-546 - shale (Grey)		
	546-600 - white lime		
	600-640 - white sand		

Information upon completion of well:

- (1) Diameter 4" inches.
- (2) Total Depth 640 feet.
- (3) Water Level 120 feet below top of ground.
- (4) Cased to 546, Size 4"
- (5) Screen: Size 2", Length 12'
- (6) Were any formations sealed against pollution?  
\_\_\_\_\_ yes, \_\_\_\_\_ no.
- If YES depth of formation \_\_\_\_\_
- Why \_\_\_\_\_
- Drillers Remarks: \_\_\_\_\_

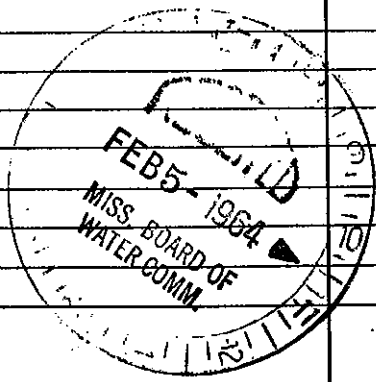

(Use Back Side)

Well No.

Mail this copy to Board of Water Commissioners 429 Miss. St. Jackson, Miss