

**JONES** MISSISSIPPI BOARD OF WATER COMMISSIONERS

C 74

**11-6-65 WATER WELL DRILLERS LOG**

Date: Nov 6, 1965, Driller: Porter Drilling & Equip. Co. Clay County, Jones  
(Name)

(1) Owner of Land: Thomas Trammel  
(Name)  
Rt 2 Laurel, Miss  
(Address)

(2) Location: SE 1/4, NW 1/4, Sec. 14 T. 9 R. 11  
3 miles NE of Laurel  
(distance) (direction) (Nearest Town)

(3) Topography: Hilly  
(Hilly) (Flat) (Level)

(4) Purpose of Well: Domestic  
(Domestic Irrigation, Municipal, Industrial, Other)

Description & Color of Materials Sand, Clay, Red Clay, Shell, etc.	Thick- ness Feet	Depth Feet
<u>red clay</u>	<u>12</u>	<u>12</u>
<u>white chalk</u>	<u>21</u>	<u>33</u>
<u>fine sandy congy chalk</u>	<u>51</u>	<u>84</u>
<u>med to med coarse sand</u>	<u>6</u>	<u>90</u>
<u>stopped white steel</u>		
<u>in sand but with</u>		
<u>some chalk</u>		

Information upon completion of well:

(1) Diameter 2" inches.

(2) Total Depth 90' feet.

(3) Water Level 40' feet below top of ground.

(4) Cased to 84', Size 2"


(5) Screen: Size 1 1/4", Length 5'  
6 slot Johnson S.S.

(6) Were any formations sealed against pollution?  
 \_\_\_\_\_ yes, X no.

If YES depth of formation \_\_\_\_\_

Why \_\_\_\_\_

Drillers Remarks: \_\_\_\_\_

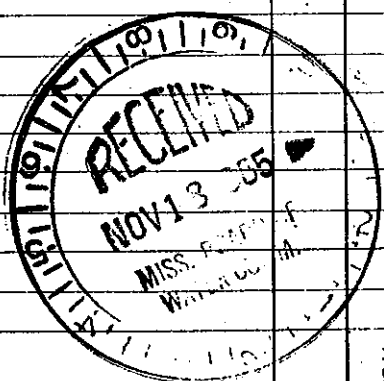

(Use Back Side)

Well No.

Mail this copy to Board of Water Commissioners 429 Miss. St. Jackson, Miss