

Jones  
C 75  
2-66

MISSISSIPPI BOARD OF WATER COMMISSIONERS

WATER WELL DRILLERS LOG

Date: Feb 1966, Driller: H. J. Morley County Jones

(1) Owner of Land:	Description & Color of Materials Sand, Clay, Red Clay, Shell, etc.	Thick- ness Feet	Depth Feet
T. L. James Const. Co. (Name) Laurel, Miss. (Address)	Clay to 60'		
(2) Location: 1/4, 1/4, Sec. T 9 N 11 W 5 miles North of Laurel (distance) (direction) (Nearest Town)	Some hard rock to 100'		
(3) Topography: (Hilly) (Flat) (Level)	Balance med		
(4) Purpose of Well: (Domestic Irrigation Municipal, Industrial, Other)	Course sand		


Information upon completion of well:

- (1) Diameter 6 inches.
- (2) Total Depth 194 feet.
- (3) Water Level 80 feet below top of ground.
- (4) Cased to \_\_\_\_\_, Size \_\_\_\_\_
- (5) Screen: Size \_\_\_\_\_, Length \_\_\_\_\_
- (6) Were any formations sealed against pollution?  
\_\_\_\_\_ yes, \_\_\_\_\_ no.

If YES depth of formation \_\_\_\_\_

Why \_\_\_\_\_

Drillers Remarks: \_\_\_\_\_

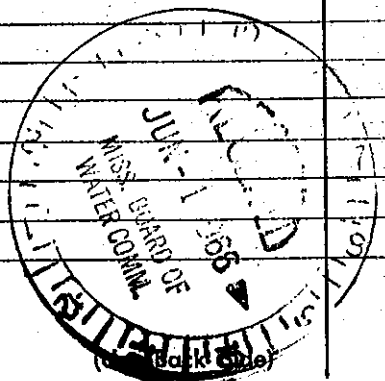

Well No. \_\_\_\_\_

Mail this copy to Board of Water Commissioners 429 Miss. St. Jackson, Miss