


Jones
C 76
5-66

MISSISSIPPI BOARD OF WATER COMMISSIONERS

WATER WELL DRILLERS LOG

Date: 5/66, 19___, Driller: W. J. Moxey County Jones
(Name)

(1) Owner of Land:	Description & Color of Materials Sand, Clay, Red Clay, Shell, etc.	Thick- ness Feet	Depth Feet
<u>T. L. James Const</u> <u>Highway Dept.</u> <u>Laurel, Miss</u> (Address) <u>15 79N11W</u>	<u>Blue Clay 18'</u>		
(2) Location: <u>1/4</u> , <u>1/4</u> , Sec. <u>T</u> , <u>R</u> , <u>8</u> miles <u>North</u> of <u>Laurel</u> (distance) (direction) (Nearest Town)	<u>168' fine sand</u> <u>186' blue chalk</u>		
(3) Topography: _____ (Hilly) (Flat) (Level)	<u>to 300' Blue</u>		
(4) Purpose of Well: _____ (Domestic Irrigation Municipal, Industrial, Other)	<u>Chert with rock</u>		
Information upon completion of well:			
(1) Diameter <u>6"</u> inches.	<u>to 505' shell to</u>		
(2) Total Depth <u>632</u> feet.	<u>515' to 587'</u>		
(3) Water Level _____ feet below top of ground.	<u>blue clay 587'</u>		
(4) Cased to _____, Size _____	<u>to 634' capped.</u>		
(5) Screen: Size <u>4"</u> , Length <u>61'</u>	<u>Dark,</u>		
(6) Were any formations sealed against pollution? _____ yes, _____ no.			
If YES depth of formation _____			
Why _____			
Drillers Remarks: _____			

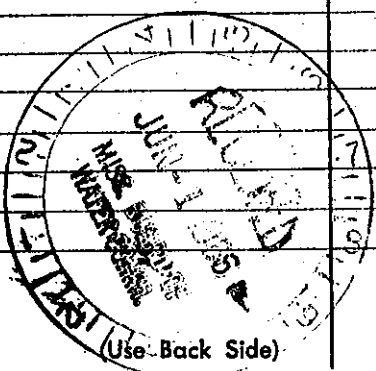

Well No.

Mail this copy to Board of Water Commissioners 429 Miss. St. Jackson, Miss.