


Jones
C 78
8-66

MISSISSIPPI BOARD OF WATER COMMISSIONERS

WATER WELL DRILLERS LOG

Date: 8/1, 1966, Driller: C. J. Clark County Jones
(Name)

(1) Owner of Land	Description & Color of Materials Sand, Clay, Red Clay, Shell, etc.	Thick- ness Feet	Depth Feet
<u>R. L. Caves</u> (Name) <u>Rt 2 Laurel, Miss</u> (Address)	<u>0-20 Sandy Clay</u>	<u>20</u>	
(2) Location: <u>NW 1/4, SW 1/4, Sec. 8, T9N, R10W</u> <u>4</u> miles <u>North</u> of <u>Laurel</u> (distance) (direction) (Nearest Town)	<u>20-55 Clay</u>	<u>35</u>	
(3) Topography: _____ (Hilly) (Flat) (Level)	<u>55-75 Sand</u>	<u>20</u>	
(4) Purpose of Well: _____ (Domestic, Irrigation, Municipal, Industrial, Other)	<u>75-198 Clay</u>	<u>123</u>	
Information upon completion of well:	<u>198-214 Sand</u>	<u>16</u>	
(1) Diameter <u>2</u> inches.			
(2) Total Depth <u>214</u> feet.			
(3) Water Level <u>148</u> feet below top of ground.			
(4) Cased to <u>142</u> , Size <u>6</u>			
(5) Screen: Size <u>1 1/4</u> , Length <u>6</u>			
(6) Were any formations sealed against pollution? <u>yes</u> , _____ no.			
If YES depth of formation <u>189</u>			
Why <u>Seal Surface Water</u>			
Drillers Remarks: _____			

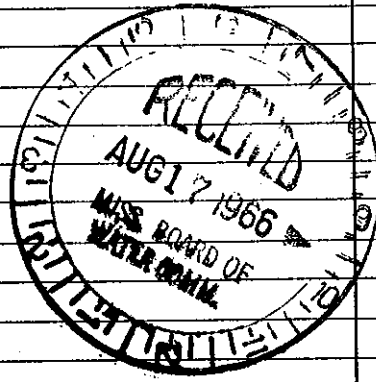

Well No.

(Use Back Side)

Mail this copy to Board of Water Commissioners 429 Miss. St. Jackson, Miss.