

Jones
C 79
9-67

MISSISSIPPI
BOARD OF WATER COMMISSIONERS
416 North State Street
Jackson, Mississippi 39201

WATER WELL DRILLERS LOG


19 9-7 date well completed 67 Roy V. West firm name Jones county well located

LANDOWNER:	description of formations encountered	from	to
<u>Clyde Walters</u>	<u>clay</u>	<u>0</u>	<u>20</u>
<u>Rt 6 Laurel</u>	<u>sandy clay</u>	<u>20</u>	<u>45</u>
<u>Miss</u>	<u>sand</u>	<u>45</u>	<u>70</u>
(mailing address)			

WELL LOCATION:
24 sec SW 10 T. N R. 11 E
3 miles N.W. of Sandersville
 (distance) (direction) (nearest town)

WELL PURPOSE: home
 (home, irrigation, municipal, industrial)

- WELL COMPLETION DATA:
- (1) diameter (inches) 2
 - (2) total depth (feet) 70 ft
 - (3) static water level (feet) 35 below top of ground.
 - (4) casing galv 65
 (material) (depth)
 - 2 If telescope see back.
 (size)
 - (5) screen 5 65
 (length) (depth to top)
 - 1 1/4 St. Steel
 (size) (material)
 - (6) pump 1/2 8
 (HP) (yield gpm)
 - R.E.A.
 (type power)
 - (7) electric log no
 (yes or no)
 - (organization running log)
 - (8) how well bottom plugged wash hole

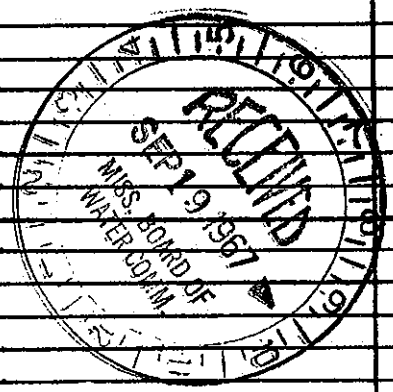

DRILLERS REMARKS: