

Jones
C 86
10-31-68

MISSISSIPPI
BOARD OF WATER COMMISSIONERS CODED
416 North State Street
Jackson, Mississippi 39201

WATER WELL DRILLERS LOG

10-31 1968 Roy V. West Jones
date well completed firm name county well located

LANDOWNER: Roy Rich
Rt 2
Laurel Miss
(mailing address)


description of formations encountered	from	to
sandy clay	0	15
sand	15	22
clay	22	40
sandy clay	40	58
clay	58	100
sand	100	118

WELL LOCATION:
sec. 1 T. 9 N. R. 11 E
2 miles W of Soudersville Miss
(distance) (direction) (nearest town)

WELL PURPOSE: home
(home, irrigation, municipal, industrial)

WELL COMPLETION DATA:

- (1) diameter (inches) 2 in
- (2) total depth (feet) 118
- (3) static water level (feet) 78 below above top of ground.
- (4) casing galv 110 (material) (depth)
- (size) If telescope see back.
- (5) screen 8 110 (length) (depth to top)
- 1/4 St Steel (size) (material)
- (6) pump 1/2 3 (HP) (yield gpm)
- Rea (type power)
- (7) electric log NO (yes or no)
- (organization running log)
- (8) how well bottom plugged Washed

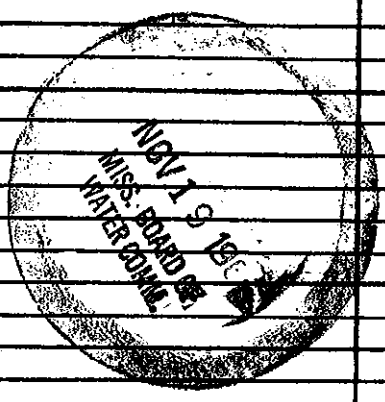

DRILLERS REMARKS: