

JONES
C 87
9-30-68

MISSISSIPPI
BOARD OF WATER COMMISSIONERS
416 North State Street
Jackson, Mississippi 39201

WATER WELL DRILLERS LOG


9.30 1968 Ray W. Jones
date well completed firm name county well located

| LANDOWNER | description of formations encountered | from | to |
|-------------------------------------|---------------------------------------|------|----|
| Jahurie Jordan Rt 1 | Red Clay | 0 | 10 |
| Heildburg Miss (mailing address) | Dark sand clay | 10 | 30 |
| | Blue clay | 30 | 45 |
| | Sand | 45 | 70 |

WELL LOCATION:
sec. 1 T 9 N R 11 E
S W
1 miles west of Seaside Miss
(distance) (direction) (nearest town)

WELL PURPOSE: Home
(home, irrigation, municipal, industrial)

- WELL COMPLETION DATA:
- (1) diameter (inches) 2
 - (2) total depth (feet) 70
 - (3) static water level (feet) 30 below above top of ground.
 - (4) casing galv, 65,
(material) (depth)
If telescope see back.
(size)
 - (5) screen 6, 65
(length) (depth to top)
1/4, Stainless steel
(size) (material)
 - (6) pump 1/2, 6
(HP) (yield gpm)
REA
(type power)
 - (7) electric log No
(yes or no)
(organization running log)
 - (8) how well bottom plugged wash water

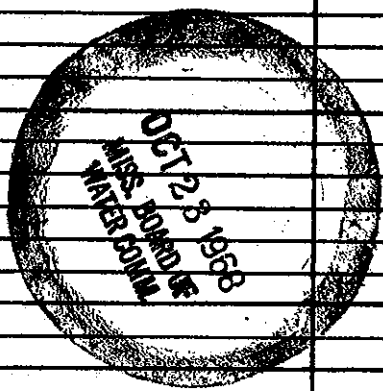

DRILLERS REMARKS: