

MISSISSIPPI BOARD OF WATER COMMISSIONERS

WATER WELL DRILLERS LOG

CODED *Unit 11/69*

Date: 4/16, 1962, Driller: C.P. Clark County Jones

(Name)

(1) Owner of Land:	Description & Color of Materials Sand, Clay, Red Clay, Shell, etc.	Thick- ness Feet	Depth Feet
<u>Milton Sampson</u> (Name) <u>Rt # 2 Laurel Miss</u> (Address)	<u>0-20 Red Clay</u>	<u>20</u>	
	<u>20-48 Sand & Gravel</u>	<u>28</u>	
(2) Location: <u>24</u> <u>9^N-1^W</u> <u>5</u> miles <u>North</u> of <u>Laurel</u> (distance) (direction) (Nearest Town)			
(3) Topography: <input checked="" type="checkbox"/> (Hilly) <input type="checkbox"/> (Flat) <input type="checkbox"/> (Level)			
(4) Purpose of Well: <input checked="" type="checkbox"/> (Domestic Irrigation) <input type="checkbox"/> (Municipal, Industrial, Other)			

Information upon completion of well:


- (1) Diameter 2 inches.
- (2) Total Depth 48 feet.
- (3) Water Level 35 feet below top of ground.
- (4) Cased to 42, Size 3
- (5) Screen: Size 1/4, Length 6ft
- (6) Were any formations sealed against pollution?
yes, no.

If YES depth of formation _____

Why _____

Drillers Remarks: _____

CODED

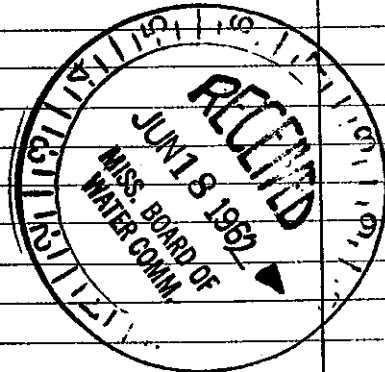

Well No.

(Use Back Side)

Mail this copy to Board of Water Commissioners 429 Miss. St. Jackson, Miss