

JONES  
D 65  
5-15-64

MISSISSIPPI BOARD OF WATER COMMISSIONERS


WATER WELL DRILLERS LOG

Date: 5/15, 1964, Driller: C.P. Clark County Jones  
(Name)

(1) Owner of Land:	Description & Color of Materials Sand, Clay, Red Clay, Shell, etc.	Thick- ness Feet	Depth Feet
E.S. Gathin Jr (Name) Rt #2 Heidelberg Miss (Address)	0-20 Sandy Clay	20	
	20-60 Sand	40	
(2) Location: 1/4, 1/4, Sec. 36 T12R04 6 miles East of Gaudensville (distance) (direction) (Nearest Town)	60-105 Clay	45	
	105-113 Sand	08	
(3) Topography: Hilly (Hilly) (Flat) (Level)	113-136 Clay	26	
(4) Purpose of Well: Domestic (Domestic Irrigation Municipal, Industrial, Other)	136-145 Clay rocks	09	
	145-147 Sand	02	
	147-180 Clay	37	
	180-220 rocks	40	
	220-265 rocks + clay	45	

Information upon completion of well:

- (1) Diameter 2 inches.
- (2) Total Depth 265 feet.
- (3) Water Level 110 feet below top of ground.
- (4) Cased to 186, Size 2 in.
- (5) Screen: Size None, Length \_\_\_\_\_.
- (6) Were any formations sealed against pollution?  
 yes,  no.
- If YES depth of formation 186
- Why Seal Surface
- Drillers Remarks:

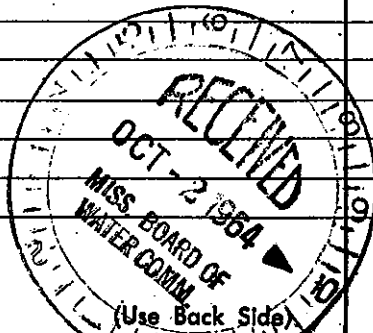

Well No.

Mail this copy to Board of Water Commissioners 429 Miss. St. Jackson, Miss.