

JONES MISSISSIPPI BOARD OF WATER COMMISSIONERS

D 37 VS 55


WATER WELL DRILLERS LOG

7-25-62

Date: 7/25, 1962, Driller: C.P. Clark County Jones

(Name)

(1) Owner of Land:	Description & Color of Materials Sand, Clay, Red Clay, Shell, etc.	Thick- ness Feet	Depth Feet
Sinclair Oil & Gas (Name) Tulsa Okla (Address)	0-16 White Clay	16	
(2) Location: NW 1/4, NW 1/4, Sec 23 T 9 N R 10 W	16-36 Sand	20	
8 miles NE of Laurel (distance) (direction) (Nearest Town)	36-67 Clay	31	
(3) Topography: (Hilly) (Flat) (Level)	67-97 Sand	30	
(4) Purpose of Well: (Domestic Irrigation) (Municipal) (Industrial) (Other)	97-156 Blue Clay	59	
Information upon completion of well:	156-165 Sand	9	
(1) Diameter 4 inches.	165-203 Blue Sand	38	
(2) Total Depth 842 feet.	203-230 Blue Clay	27	
(3) Water level 123 feet below top of ground.	230-250 Clay & rocks	20	
(4) Cased to 836, Size 4 in.	250-262 Blue Sand	12	
(5) Screen: Size 3 3/4, Length 52.	262-360 Red Clay	98	
(6) Were any formations sealed against pollution?	360-520 Clay & shells	160	
<input checked="" type="checkbox"/> yes, <input type="checkbox"/> no.	520-660 brown Clay	140	
If YES depth of formation 734	660-674 Sand & shells	14	
Why Seal all water from above	674-714 Sand & shells	40	
Drillers Remarks: Above	714-722 Sand & shells	08	
	722-736 Clay	14	
	736-740 Sand & shells	4	
	740-750 Shells	10	
	750-767 Sand	17	
	767-771 Mixed Sand	4	
	771-796 Sand	25	

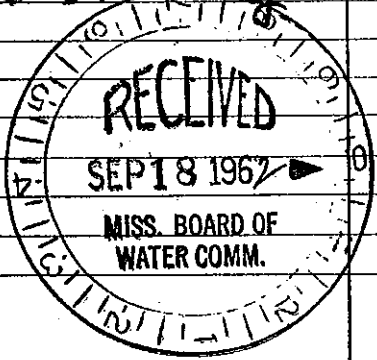

(Use Back Side)

Well No.

is copy to Board of Water Commissioners 429 Miss. St. Jackson, Miss.